


Section 31 Township 21 Range 11W

Well No. #1 Mellies "B"

Company Altman Petroleum

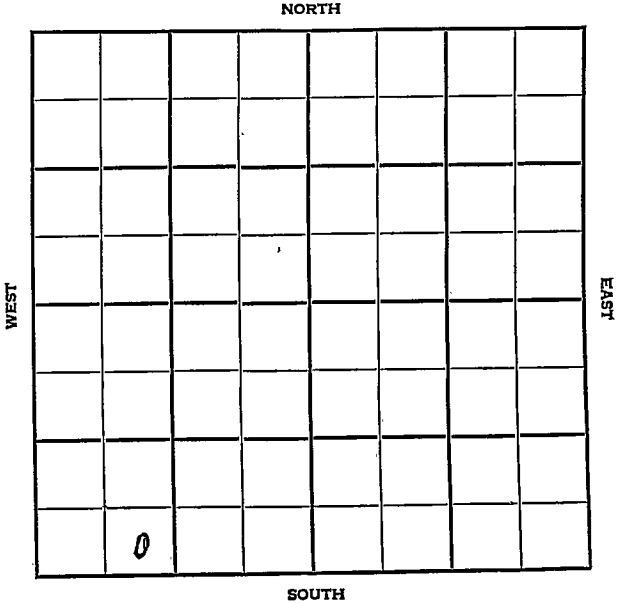

County Stafford Elev. 1775Sec. 31 Twp. 21 Rge. 11WCompany Altman PetroleumFarmName Mellies "B" No. 1

TOPS

DEPTH

LOG

DATUM

Loc. in Sec.

Anh.

SE SW SW

Tp.

H.

Tr.

Dg.

Bl.

L.

K.C.

B.K.C.

Ce.

C.

M.

M.

K.

Mz.

Mq.

V.

S.

S.

A.

R.

PE.

G.

T.D.

Geol.

Contr.

Jackson

Pool

Duggan Ext.

FIRST REPORT	
JAN 9 '57	
0	

Date Comm. 12-30-57

8" @ 320 drlg. 3534

13

Co.

Loc.

No.

Sec.

T.

R.

County Stafford Elev. 1775
 Sec. 31 Twp. 21 Rge. 11W
 Company Altman Petroleum
 FarmName Mellies "B" No. 1

TOPS //	DEPTH	LOG	DATUM	Loc. in Sec.
Anh. //				SE SW SW
Tr.				
H.	3034			
Tr.				
Dg.				
BL.	3164			
L.	3190			Geol.
K.C.				Contr.
B.K.C.				Jackson
Ce.				Pool
C.	3469			Duggan Ext.
M.				
M.				
K.				
Mz.				
Ma.				
V.				
S.	3530			
S.				ABANDONED
A.	3586			
R.				
PE.				
G.				
TD.	3605			

Date Comm. 12-30-57

8" @ 320 drls. 3534

JAN 15 '57

DST 3519-40 of 1hr 18' MD
 BHP 0/20"

DEA