

Pawnee KANSAS

Company Aurora & Trans-Era

WEST

EAST

SOUTH

0

Pawnee KANSAS

SEC.	TWP.	R.
31	21	20W

WELL NO.

I Rucker FARM

COMPANY

Aurora & Trans-Era

CONTRACTOR

Trans-Era

Wildcat

330


Ft. from N. Line

Ft. from S. Line

330

Ft. from E. Line

Ft. from W. Line

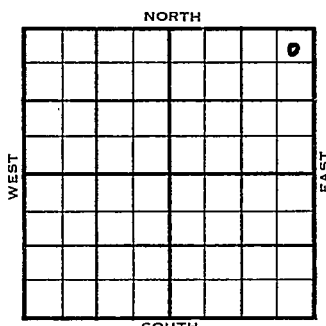

NE NE NE Atl. FO

Phillips, Gulf & Atl. - DHM - Superior DHM&AC

1955

ELEVATION

REPORT

2122'

2/9

RUR

3/2

Spud 2-9-55 - D&A

TD 4761'

13" @ 158'

Lans. 3753', B KC 4038', Miss 4329'

DST 4331-37', opn 1 hr., rec. 15' mud, 145#

Viola 4437', Simp. sh 4650'

DST 4336-47, opn 1 hr., rec. 30' mud, O#

TD 4761'

Log Tops: Heeb. 3677', B. Oread 3708'

Lans. 3758', Miss 4326', Kh. 4388'

Viola 4432', Simp. 4654', Arb. 4698'

D&A

ABANDONED

County **Pawnee** State **Kansas**

Sec. **31** (Blk. **21** (Sur. **20W** Map No.

Operator **Aurore & Trans-Era**

Well No. **1** Farm **Rucker**

Elev.	Location	NE NE NE
-------	----------	----------

FIRST REPORT

330 Ft. From E Line NE

330 Ft. From E Line Quarter

1st. Report FEB 9 1955

Completion _____

Remarks _____

Trans-Era - Contr.

Spudding Date _____

Drlg. Data Wildcat

Phillips, Gulf & Atl. - DEM Atl. farmout

Superior - DEM & AC

R U R


FABEN GILSTRAP

County Pawnee State Kansas
 Sec. 31 (Blk. 21 (Sur. 20W Map No.
 Twp.) Rge.)

Operator Aurora & Trans-Era

Well No. 1 Farm Rucker

Elev. 2122 Location NE NE NE

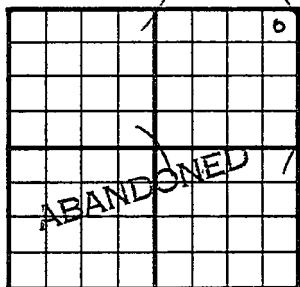

330 Ft. From N Line NE

330 Ft. From E Line Quarter

1st. Report

Completion MAR 2 1955

Remarks Wildcat

Trans-Era - Contr.

Spudding Date 2-9-55

Drlg. Data D & A TD 4761

13" @ 158 Lens. 3753 B KC 4038

Miss. 4329 DST 4331-37 open 1 hr.

Rec. 15' mud 145# Viola 4437

Simp. sh. 4650 DST 4336-47 open 1 hr.

Rec. 30' mud 0# TD 4761

LOG TOPS:

Heeb. 3677 B. Oread 3708 Lens. 3758

Miss. 4326 Kh. 4388 Viola 4432

Simp. 4654 Arb. 4698

D & A

FABEN GILSTRAP