

Finney

KANSAS

SECTION 31 TOWNSHIP 21S RANGE 33W

WELL NO. #1-Maune


COMPANY Nate Appleman

C NW/4

NORTH

WEST

EAST

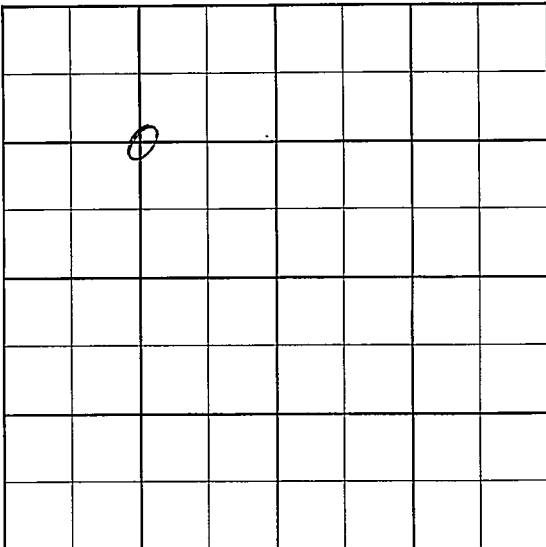

SOUTH

County Finney Elev. _____
 Sec. 31 Twp. 21 Rge. 33W
 Company Nate Appleman
 Farm Name Maune No. 1

Co.

Lse.

No.

Sec.

T.

R.

TOPS DEPTH LOG DATUM

Anh.			
Tr.			
H.			
Tr.			
Dg.			
Bl.			
L.			
K.C.			
B.K.C.			
Ce.			
C.			
M.			
M.			
K.			
Mz.			
Mq.			
V.			
S.			
S.			
A.			
R.			
Pe.			
G.			
T.D.			

Loc. in Sec.

C NW 1/4

Geol.

Contr.

Garvey

Pool

Hugoton

FIRST REPORT	
JUL 17 '57	

Date Comm. 7-13-57

8" @ 289/200 drlg. 2/45

[Handwritten signature]

County Finney Elev. 2900
 Sec. 31 Twp. 21 Rge. 33W
 Company Nate Appleman
 Farm Name Maune No. 1

TOPS	DEPTH	LOG	DATUM	Loc. in Sec.
Anb.				
Tp. <u>Herr</u>	<u>2515</u>			<u>C NW/4</u>
H.				
Tr.				
Dg.				
Bl.				
L.				
K.C.				Geol. _____
B.K.C.				Contr. _____
Ce.				<u>Garvey</u>
C.				
M.				Pool _____
M.				<u>Hucoton</u>
K.				
Mz.				
Mo.				
V.				
S.				
S.				
A.				
R.				
Pe.				
G.				
TD	<u>2520</u>			

AUG 7 '57	
COMPLETE	

Date Comm. 7-13-578" @ 289/200 2645 UL 24 '575 1/2 2519 MICT AUG 8 '57DD 2537 ga 1.250 MCF FRAC 10X10ga 5 M 11 CFB / 12 hrs