


Section 32 Township 21 Range 12WWell No. 1 MuellerCompany Plains Exploration

Mueller Pool

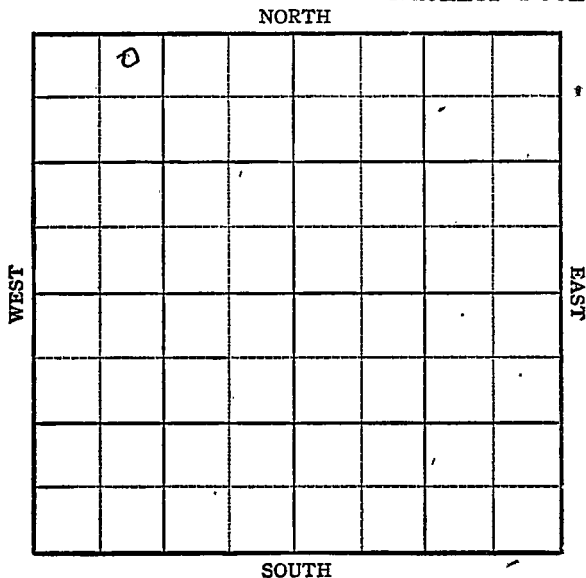

KANSAS

Stafford

Sec. 32 Twp. 21 R. 12W

Well No. #1 Mueller Farm

Plains Exploration Company

Mueller Pool


330' Ft. from N. Line

 Ft. from S. Line

 Ft. from E. Line

990' Ft. from W. Line

NE NW NW

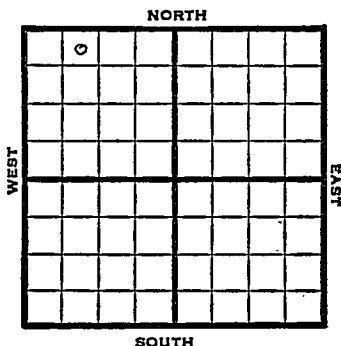

1948' Elev. 1863' REPORT

10/20 Location

10/26 8" @ 267'

Drlg. 1900'

11/3 Lansing 3272'

Viola 3515'

Drlg 3560'

11/10 Simpson 3555'

Arb 3607

TD 3615'

5" @ 3608'

300 acid

11/17 Arb 3607'

5" @ 3608'

300 acid

Pump 25 oil & 30% W Pot.

Gr. 40

TD 3615'

COMPLETED

Map No. _____ Sec. 32 Twp. 21 R. 12W

Well No. 1 Mueller

Plains Exploration Company

FIRST REPORT

Contractor

NE NW NW

SECTION PLAT

330 Ft. from N. Line

_____ Ft. from S. Line

_____ Ft. from E. Line

990 Ft. from W. Line

Stafford County

Location X

Rig up _____

Drilling and Remarks:

RECORD

Cased _____ in., _____ ft.

Sand _____

Gas _____

Oil _____

Total Depth _____

PRODUCTION

1st 24 hrs. Nat. _____

1st 24 hrs. after shot _____

Gas _____ Cu. Ft.

Dry Hole _____

Abandoned _____

Date

OCT 20 1948 19

S. J. LEWIS Scout

Map No. 46 Sec. 32 Twp. 21 R. 12W

Well No. 1 Mueller

Plains Exploration Company

COMPLETE

Contractor

NE NW NW


E 1/8 63
SECTION PLAT

330 Ft. from N. Line

 Ft. from S. Line

 Ft. from E. Line

990 Ft. from W. Line

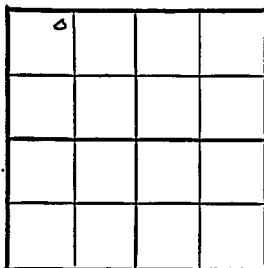

Stafford County

Location

Rig up

Drilling and Remarks:

Cr 8607

5" @ 8608

200 acid

Prod 25 oil +

80% NW 1/4

40 @ 86

RECORD

Cased in., ft.

Sand

Gas

Oil ✓

Total Depth 8615

PRODUCTION

1st 24 hrs. Nat.

1st 24 hrs. after shot

Gas Cu. Ft.

Dry Hole

Abandoned

Date

NOV 17 1948

19

S. J. LEWIS

Scout