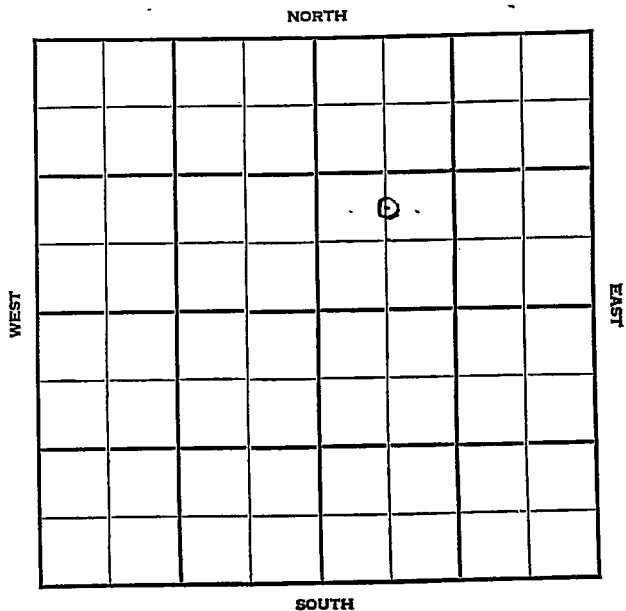


Section 32 Township 21 Range 12WWell No. #1 UlmsteadCompany Keweenaw Drlg

KANSAS

Stafford

✓

Sec. **32** Twp. **21** R. **12W**

Well No. **#1 Ulmstead** Farm

Keyes Drlg. Company

Mueller Pool


Ft. from N. Line

990' Ft. from S. Line

Ft. from E. Line

660' Ft. from W. Line

C N L SW NE

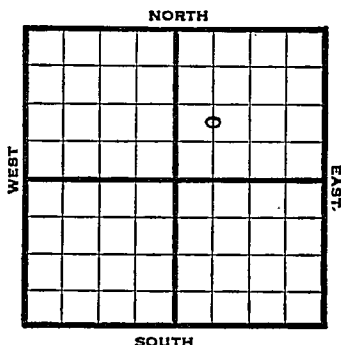

1948 Elev. **1867'** **REPORT**

2/4 Location

2/11 10" @ 290'
Drlg. 2690'

2/18 Lansing 3207'
Viola 3540'
Simpson 3675'
Arbuckle 3707'
TD 3716'
5" @ 3707'

2/25 Simpson 35758
Arb. 3607'
5" @ 3608'
TD 3646'
Abd.

ABANDONED

Map No. _____ Sec. 32 Twp. 21 R. 12W

Well No. 1 Ulmstead


Keyes Drlg. Company

FIRST REPORT

Contractor

C N L SW NE

SECTION PLAT

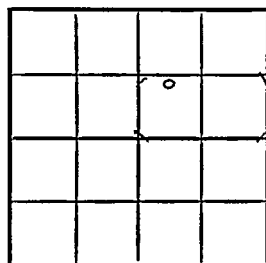

_____ Ft. from N. Line

990 Ft. from S. Line

_____ Ft. from E. Line

660 Ft. from W. Line

Stafford County

Location X

Rig up _____

Drilling and Remarks:

RECORD

Cased _____ in., _____ ft.

Sand _____

Gas _____

Oil _____

Total Depth _____

PRODUCTION

1st 24 hrs. Nat. _____

1st 24 hrs. after shot _____

Gas _____ Cu. Ft.

Dry Hole _____

Abandoned _____

Date

FEB 4 1948

19

S. J. LEWIS Scout

Map No. 46 Sec. 32 Twp. 21 R. 12W

Well No. 1 Umstead

Keyes Drlg. Company

ABANDONED

Contractor

C N L SW NE

E. 1867
SECTION PLAT

		0	

 Ft. from N. Line

990 Ft. from S. Line

 Ft. from E. Line

660 Ft. from W. Line

Stafford County

Location

Rig up

Drilling and Remarks:

Simpson 3525
Cr 8607
5-18608.

RECORD

Cased in., ft.

Sand

Gas

Oil

Total Depth 2646

PRODUCTION

1st 24 hrs. Nat.

1st 24 hrs. after shot

Gas Cu. Ft.

Dry Hole

Abandoned

Date

FEB 25 1948 19 S. J. LEWIS Scout