


Section 32 Township 21 Range 12W

Well No. 1 Walker

Company Westgate - Greenland

Mueller

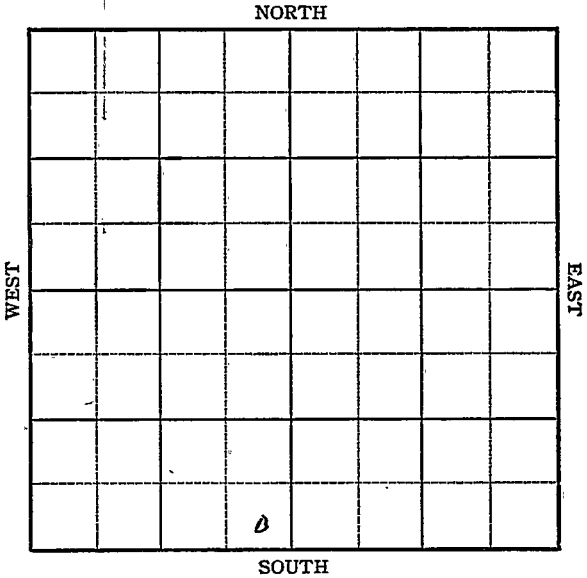

KANSAS

Stafford

Sec. 32 Twp. 21 R. 12W

Well No. #1 Walker Farm

Westgate-Greenland Company
Mueller Pool

 Ft. from N. Line


330'

 Ft. from S. Line

330'

 Ft. from E. Line

 Ft. from W. Line

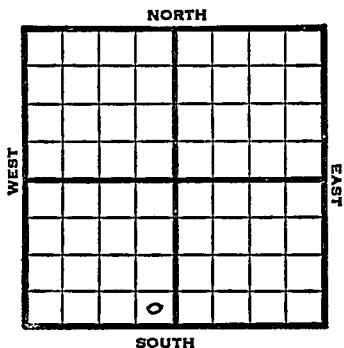

SE SW

1949

Elev 1870'

REPORT

3/30

8" @ 296'

Drlg. 1287'

4/6

Drlg. 1750'

4/12

Lansing 3297'

Arnbuckle 3639'

TD 3643'

5" @ 3639'

4/20

TD 3643'

Arb. 3639'

5" @ 3639'

Aband.

ABANDONED

Map No. _____ Sec. 32 Twp. 21 R. 12W

Well No. 1 Walker

Westgate-Greenland Company

FIRST REPORT Contractor

SE SW


SECTION PLAT

_____ Ft. from N. Line

330 Ft. from S. Line

330 Ft. from E. Line

_____ Ft. from W. Line

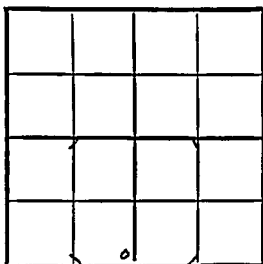

Stafford County

Location _____

Rig up _____

Drilling and Remarks:

8" @ 296

drlg. 1287

RECORD

Cased _____ in., _____ ft.

Sand _____

Gas _____

Oil _____

Total Depth _____

PRODUCTION

1st 24 hrs. Nat. _____

1st 24 hrs. after shot _____

Gas _____ Cu. Ft.

Dry Hole _____

Abandoned _____

Date

MAR 30 1949 19

S. J. LEWIS

Scout

Kansas

Mueller Pool

Map No. 246 Sec. 32 Twp. 21 R. 12WWell No. 1 WalkerWestgate-Greenland

Company

ABANDONED

Contractor

SE SW

E 11870
SECTION PLAT

 Ft. from N. Line330 Ft. from S. Line330 Ft. from E. Line Ft. from W. Line

Stafford County

Location Rig up

Drilling and Remarks:

Cor 836285" @ 3639

RECORD

Cased in., ft.Sand Gas Oil Total Depth: 3643

PRODUCTION

1st 24 hrs. Nat. 1st 24 hrs. after shot Gas Cu. Ft.Dry Hole Abandoned

Date

APR 20 1949

19

S. J. LEWIS

Scout