

KANSAS


FORM 51 5M 6-46 PETROL

Stafford County

Section ~~33~~ 32 Township 21 Range 12W

Well No. #3 Walker

Company Stanolind

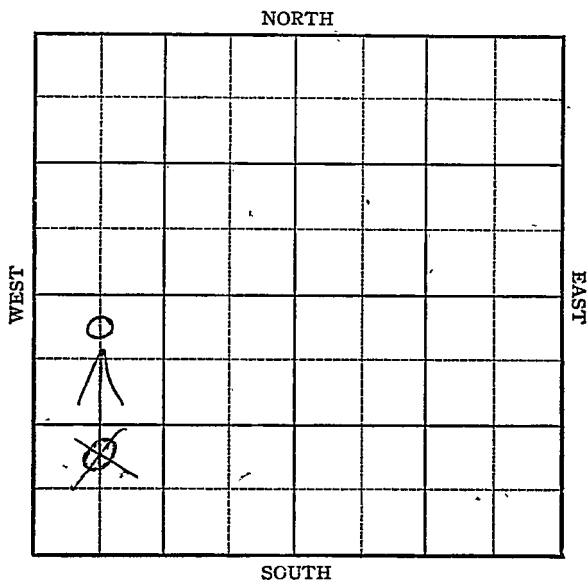

KANSAS

Stafford County ✓

Sec. 33 22 Twp. 21 R. 12W

Well No. #3 Walker Farm

Stanolind

Sittner Company

330 Ft. from N. Line


990 Ft. from S. Line

_____ Ft. from E. Line

660 Ft. from W. Line

NW

CNL SW-SW

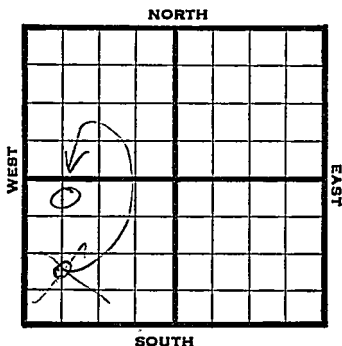

1946

1867

REPORT

7/10 13" @ 233
Drlg. 980'

7/16 Drlg 2965'

7/23 Lans 3284'
Arb 3618-22 TD
Run csg.

7/30 5" @ 3620'
Swb 5 oil PH 8 hrs
500 acid

8/6 " " "

8/13 " " "

8/20 " " "

8/27 " " "

9/5 " " "

9/10 " " "

9/18 Arb 3618'
5" @ 3620'
TD 3622'
Acid 500
Pump 39 oil plus 42% W Pot
Grav. 40

COMPLETED

KANSAS Kansas Pool Name SittnerMap No. 76 Sec. 33 Twp. 21 R. 12WWell No. 3 WalkerStanolind CompanyFIRST REPORT Contractor

C N L SW SW

SECTION PLAT

 Ft. from N. Line990 Ft. from S. Line Ft. from E. Line660 Ft. from W. Line

o			

Stafford CountyLocation Rig up

Drilling and Remarks:

13" @ 233'
980'

RECORD

Cased in., ft.Sand Gas Oil Total Depth

PRODUCTION

1st 24 hrs. Nat. 1st 24 hrs. after shot Gas Cu. Ft.Dry Hole Abandoned

Date

JUL 10 1946 19 S. J. LEWIS Scout

KANSAS

Kansas Pool Name SittnerMap No. AP Sec. 32 Twp. 21 R. 12WWell No. 3 WalkerStanolind

Company

CORRECTION

Contractor

C N L NW SW

SECTION PLAT

330 Ft. from N. Line Ft. from S. Line Ft. from E. Line660 Ft. from W. Line

o			

Stafford CountyLocation Rig up

Drilling and Remarks:

Reported

C N L SW SW

33-21-12W

RECORD

Cased in., ft.Sand Gas Oil Total Depth

PRODUCTION

1st 24 hrs. Nat. 1st 24 hrs. after shot Gas Cu. Ft.Dry Hole Abandoned

Date

JUL 17 1946 19S. J. LEWIS Scout

KANSAS

Kansas


Pool Name Sittner PoolMap No. 46 Sec. 32 Twp. 21 R. 12WWell No. 3 WalkerStanolind

Company

COMPLETED

Contractor

C N L NW SW

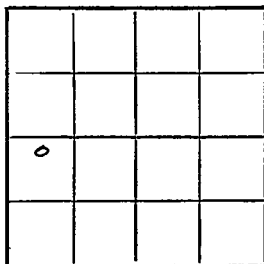E 11827
SECTION PLAT330 Ft. from N. Line Ft. from S. Line Ft. from E. Line660 Ft. from W. Line

Stafford County

Location Rig up

Drilling and Remarks:

CR 36185" @ 3620500cc oilPump 3 7/8" + 4 1/2"W 2 1/2"400 cc

RECORD

Cased in., ft.Sand Gas Oil Total Depth 3622

PRODUCTION :

1st 24 hrs. Nat. 1st 24 hrs. after shot Gas Cu. Ft.Dry Hole Abandoned

Date

SEP 1 8 1946 19

S. J. LEWIS

Scout