

KANSAS


FORM 51 5M 6-46 PETROL

Stafford county

Section 32 Township 21 Range 12-W

Well No. #4, Walker

Company Stanb lind Oil and Gas Company

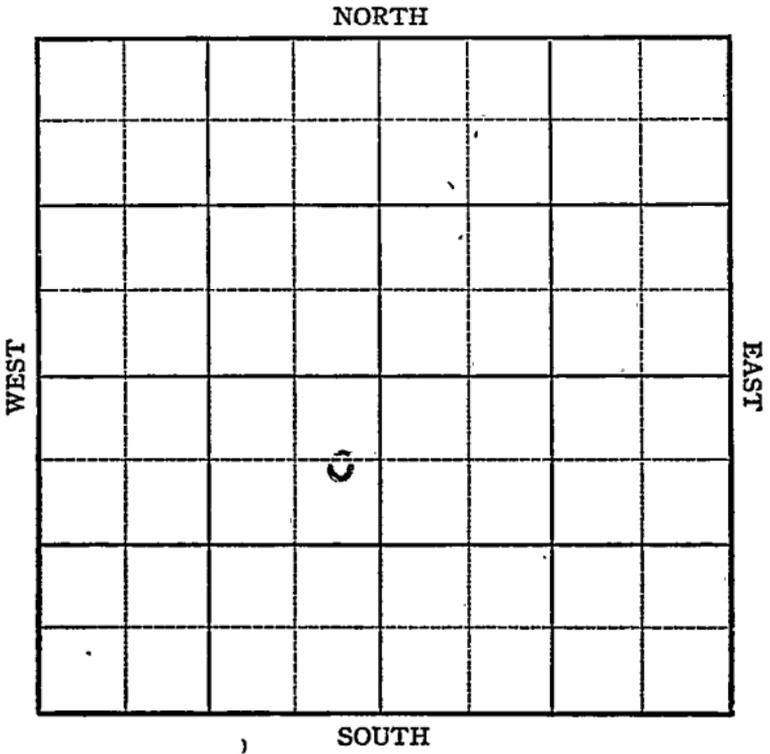

Sec. 32 Twp. 21 R. 12W

Well No. 4 Walker Farm
Stanolind Company


Mueller

660 Ft. from N. Line

_____ Ft. from S. Line

330 Ft. from E. Line

_____ Ft. from W. Line

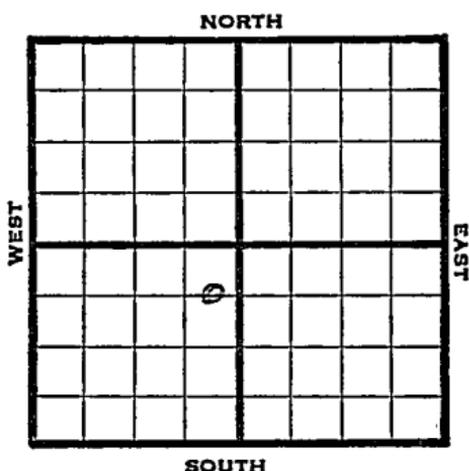

C E L N E SW

1946 Elev. 1871' REPORT

11/20 Location
11/27 RUR
12/3 Anhy 670'
8" 680'
Drlg 2910'
12/10 Mans 3287'
Cong 3526'
Simp 3570'
Arb 3630'
TD 3646 Sat
12/18 Arb 3630'
TD 3661'

ABANDONED

Map No. 46 Sec. 32 Twp. 21 R. 12W

Well No. 4 Walker

Stanolind Company

FIRST REPORT

Contractor

C E L NE SW

SECTION PLAT

660 Ft. from N. Line

_____ Ft. from S. Line

330 Ft. from E. Line

_____ Ft. from W. Line

	o		

Stafford County

Location X

Rig up _____

Drilling and Remarks:

RECORD

Cased _____ in., _____ ft.

Sand _____

Gas _____

Oil _____

Total Depth _____

PRODUCTION

1st 24 hrs. Nat. _____

1st 24 hrs. after shot _____

Gas _____ Cu. Ft.

Dry Hole _____

Abandoned _____

Date

NOV 20 1946 19

S. J. LEWIS Scout

