


Stafford

KANSAS

SECTION 32 TOWNSHIP 21 RANGE 11W

WELL NO. #2 Bauer

COMPANY Hilton Drlg.

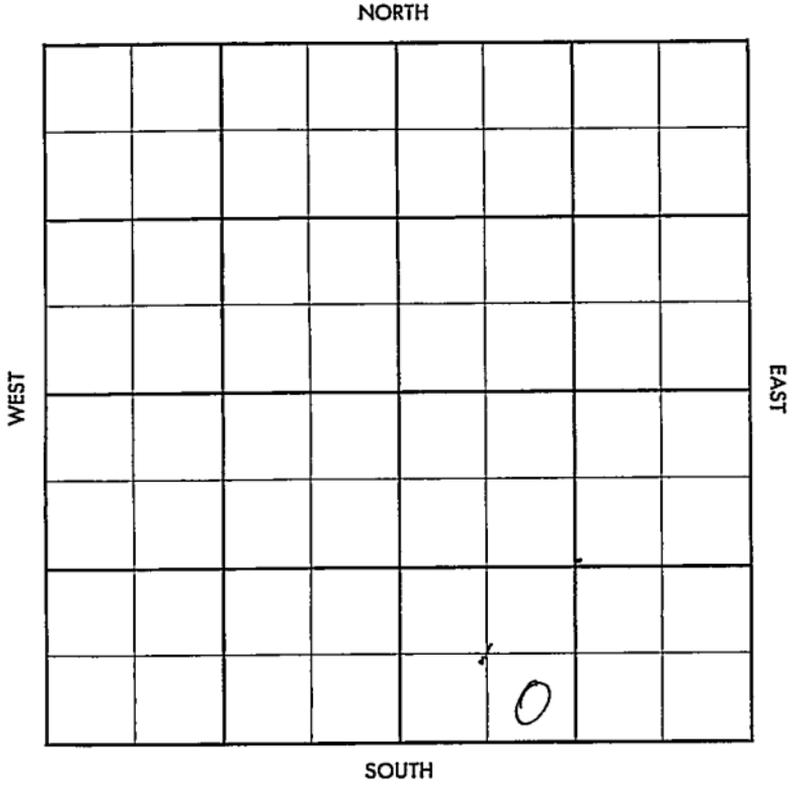

County Stafford Elev. \_\_\_\_\_  
 Sec. 32 Twp. 21 Rge. 11W  
 Company Hilton Drlg.  
 FarmName Fauser No. 2

TOPS	DEPTH	LOG	DATUM
Anh.	878		
Tp.			
H.			
Tr.			
Dg.			
Bl.			
L.			
K.C.			
B.K.C.			
Ce.			
C.			
M.			
M.			
K.			
Mz.			
Mo.			
V.			
S.			
S.			
A.			
R.			
PE.			
G.			
T.D.			

Loc. in Sec. SE SW SE

Geol. \_\_\_\_\_  
 Contr. Co. tools

Pool \_\_\_\_\_  
 Radium Twst. \_\_\_\_\_

FIRST REPORT

SEP 26 '56

3/8 mile

Date Comm. 9-19-56  
8" @ 280/225 drlg. 2972

R.G.

Co.  
 Sec.  
 No.  
 Sec.  
 T.  
 R.

County Stafford Elev. 1947  
 Sec. 32 Twp. 21 Rge. 1NW  
Union Drls.  
 Layer No. 2

TOPS	DEPTH	LOG	DATUM	Loc. in Sec.
Anh.	878			S <sup>1</sup> SW SE
Tp.				
H.	3318			
Tr.				
Dg.				
Bl.	3437			
L.	3446			
K.C.				Geol.
B.K.C.	3678			Contr.
Ce.				
C.	3709			
M.				Pool <u>UNCOLN</u>
M.				
K.				Radium Twst
Mz.				
Mo.				
V.	3745			COMPLETE
S.	3785			
S.				NOV 7 '56
A.	3838			3/8 mile
R.				18
PE.				0
G.				
TD.	3860			

Date Comm. 9-19-56

8" @ 280/225 drls. 2" 2 1/4" 3 '56

DST 3564-80 30" 10' Md (USSO)

BHP 585/20" DST 3584-3624

1hr 55' 0" GCM + 120' 50" G.C.

MW FP 25'-100 BHP 1250/20

DST 3842-60 net 45" 120' gas

+ 1320' oil FP 180-480 BHP

1100/15" 5 1/2 @ 3842/450 NET 10 '56

DST 17 '56 CO = 3860 FU 2700' oil net/w

5 hrs \$ 16.34 B0 no/wi \$/hr  
1300' 0.13 POK OCT 21 '56 OCT 31 '56 NOV 1 '56  
Ph P. 178 Bopd no/w  
gran 32°