


Section 32 Township 21 Range 11WWell No. #1 BauerCompany Petroleum Inc.

NORTH

WEST

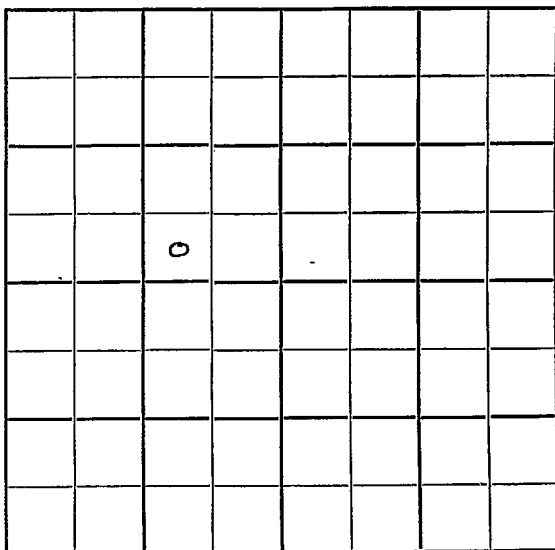

EAST

SOUTH

Sec. 32 Twp. 21 R. 14W

Well No. #1 Bauer Farm

Petroleum Inc. Company

Garvey Contractor

Wildcat


Ft. from N. Line

330 Ft. from S. Line

990 Ft. from E. Line

Ft. from W. Line

SW SE NW

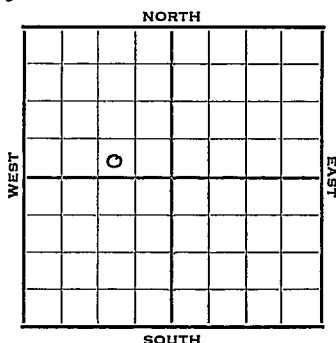

1952 Elev. 1954' REPORT

4/30 Spud 4-25-52
8" @ 274'
Anhy 887'
Drlg. 2136'

5/7 Spud 4-25-52
D&A TD 3851' 8" @ 274'
Anhy 887 Heeb. 3316
Br Li 3434 Lans. 3439
EST 3561-73, open 1 hr. rec. 50' mud
& SO
Cong. 3714 Viola 3716
Simp. 3764 Arb. 3821
TD 3851' D&A

ABANDONED



State KANSAS

Operator **Petroleum Inc.**

Well No. 7 Farm Bauer

Elev.	Location	SW	SE	NW
-------	----------	----	----	----

2

FIRST REPORT

330 Ft. From S Line NW

990	Ft. From	E. Line	Quarter
-----	----------	---------	---------

1st. Report APR 30 1952

Completion

Remarks	Lion - support
---------	----------------

Garvey - Contr.

Spudding Date **4-25-52**

Drig. Data

Wildcat

8" @ 274 Anhy 887 Drlg. 2136

J. G. McGEHEE

J. G. McGEHEE