


Stafford **KANSAS**

SECTION 32 TOWNSHIP 21 RANGE 14W

WELL NO. #6 Bauer

COMPANY Hilton Drlg.

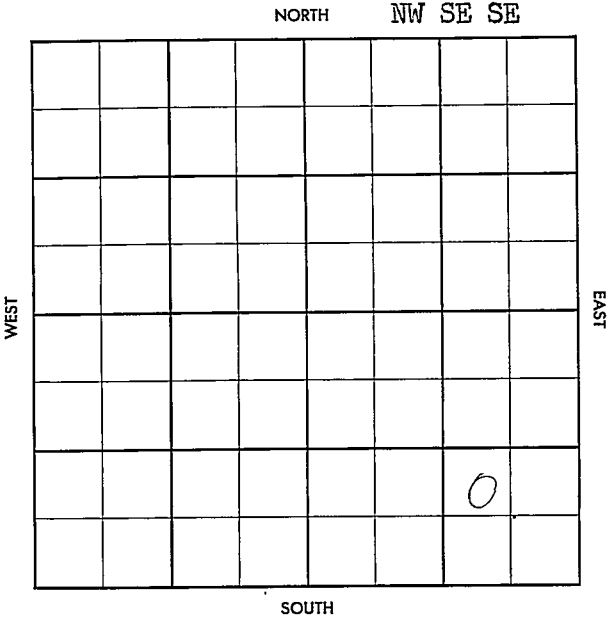

County Stafford Elev. _____
 Sec. 32 Twp. 27 Rge. 7/W
 Company Hilton Drlg.
 FarmName Bauer No. 6

TOPS	DEPTH	LOG	DATUM	Loc. in Sec.
Anh.				NW SE SE
Tp.				
H.				
Tr.				
Dg.				
Bl.				
L.				Geol. _____
K.C.				Contr. _____
B.K.C.				<u>Hilton</u>
Ce.				Pool <u>LINCOLN</u>
C.				<u>Radium Twst.</u>
M.				
M.				
K.				
Mz.				
Me.				
V.				
S.				
S.				
A.				
R.				
PE.				
G.				
T.D.				

HILTON
 Pool LINCOLN
Radium Twst.

TEST REPORT
 JAN 23 '57

Date Comm. 7-22-57

~~13~~

Co.
Lse.
No.
Sec.
T.
R.

County Stafford Elev. 1948
 Sec. 32 Twp. 21 Rge. 11W
 Company Hilton Drls.
 Farm Name Bauer No. 6

TOPS	DEPTH	LOG	DATUM	Loc. in Sec.
Anh.	875			NW SE SE
Top				
H.	3310			
Tr.				
Dg.				
Bl.	3427			
L.	3435			
K.C.				Geol.
BKG.	3672			Contr.
Ce.				Hilton
C.	3706			
M.				Pool LINCOLN
M.				Radium Twst.
K.				
Mz.				
Ma.				
V.	3730			
S.	3762			
S.				
A	3819	3870?		
R.				
PE.				
G.				
TD.	3900			

COMPLETE
 MAR 13 '57

Date Comm. 1-22-57 JAN 30 '57 8 7/8 280/200

3222 FEB 6 '57 DST 3840-56

90" net 3240' oil BHP 1230/20

DST 3856-70 1 hr 3210' oil

BHP 1230/20 5 1/2 @ 3898 FEB 13 '57

MILT FEB 20 '57 CO 48/3840-48

FU 1500' oil in 1 hr & 5 Boph.

now FU 3000' oil now in 10 hrs

TER FEB 21 '57 RUP MAR 2 '57 MAR 13 '57

P 204 BD. & tract