

Section 32 Township 21 Range 14W

Well No. #1 Cox

Company Petroleum, Inc.

NORTH

							0

WEST

EAST

SOUTH

Sec. 32 Twp. 21 R. 14W ✓

Well No. #1 Cox Farm _____

Petroleum Inc. Company _____

Garvey Contractor _____

Lincoln

330 Ft. from N. Line


_____ Ft. from S. Line

330 Ft. from E. Line

_____ Ft. from W. Line

NE NE NE

MC has SW of 33

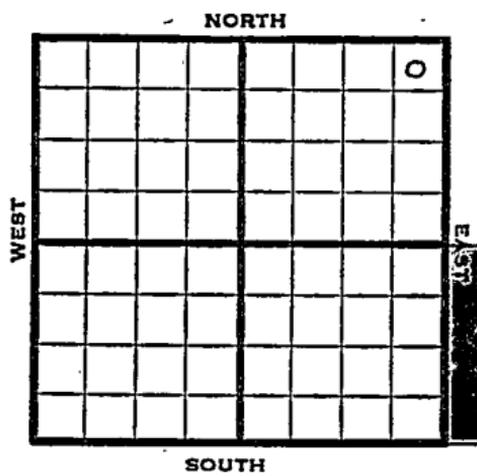

1951	Elev. 1947'	REPORT
10/31	Spud 10-26-51 8" @ 254' Drlg. 1241'	
11/9	Heeb 3298' Br. line 3414' Lans. 3423'*	Drilling at 3558' (Ltr)
11/16	Took DST 3540-58, open 1 hr., rec 900' gas & oil. 820#. Took NST 3610-24, open 1 hr., rec 75' OCM. 640#. Cong. 3701', Viola chert 3708' Simp. 3749' * Arb. 3805-3808' TD * Set 5" @ 3807'.	(Ltr)
11/30	Cleaned out to 3580' 47/3546-54. Test 3 BOPH, no water for 12 hrs., 250 A. Test 8 BOPH for 12 hrs. Putting on pump.	"
1952 1/9	Spud 10-26-51 Oil Well TD 3808' 8" @ 254' Heeb 3298 Br. Li 3414 Lans. 3423	

OVER

1952

1/9 DST 3540-58 open 1hr. Rec. 900' gas
& oil
DST 3610-24 open 1 hr. rec. 75' OCM
Cong. 3701 Viola 3708
Simp. 3749 Arb. 3805-08
5" @ 3807 CO to 3580
47/ 3546-54 3 BOPH 250 A
8 BOPH Comp. BHB 712 BOPD
6% wtr.

COMPLETED

County Stafford State Kansas

Sec. 32 (Blk.) 21 (Sur.) 14W Map No.

Operator Petroleum Inc.

Well No. I Farm Cox

Elev. _____ Location NE NE NE

					0

FIRST REPORT

330 Ft. From N Line NE

330 Ft. From E Line Quarter

1st. Report OCT 31 1951

Completion _____
 Remarks MC has SW of 33
Garvey - Contr.
 Spudding Date 10-26-51

Drlg. Data Lincoln

8" @ 254' Drlg. 1241

J. E. TYRA

Scout Cards

my

Land Small Map

Land wall Map

5

Tracings

France Map

Pierce Map

Misc.

NOV 7 1951

Orig. Data

County Stafford State Kansas

Sec. 32 (Blk. 21 (Sur. 14W (Twp.) (Rge.) Map No.

Operator Petroleum Inc.

Well No. 1 Farm Cox

Elev. 1947 Location NE NE NE

						0

330 Ft. From N Line NE

330 Ft. From E Line Quarter

1st. Report

Completion JAN 9 1952

Remarks Lincoln Pool

Garvey - Contr.

Spudding Date 10-26-51

Drlg. Data Oil well TD 3808

8" @ 254 Heeb. 3298 Br. lime 3414

Lans. 3423 DST 3540-58 open 1 hr.

Rec. 900' gas & oil DST 3610-24 open 1hr

Rec. 75' ocm Cong. 3701 Viola 3708

Simp. 3749 Arb. 3805-08 5" @ 3807

CO to 3580 47/ 3546-54 3 boph 250 A

8 boph Comp. BHB 712 bopd 6% water

J. E. TYRA

Scout Cards
Land Small Map
Land Wall Map
Tracings
France Map
Pierce Map
Misc.

JAN 16 1952