


FORM 51 25M 3-49 PETROL

Section 32 Township 21 Range 11W

Well No. #3 Cox "A"

Company Petroleum Inc.

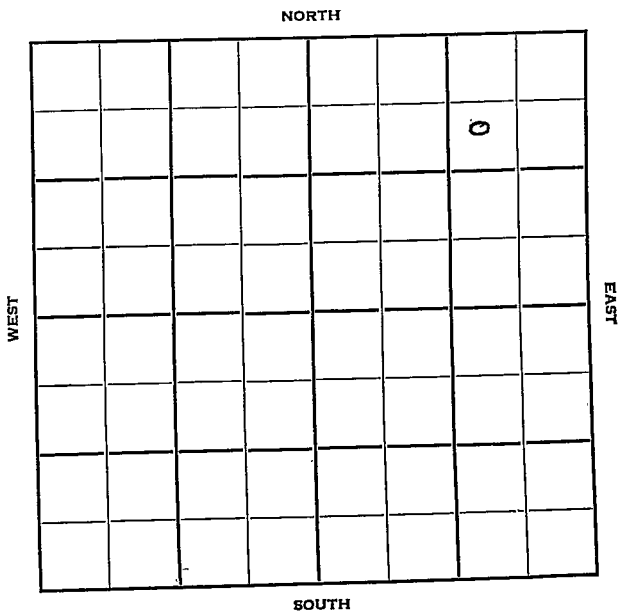

Well No. # 3 Cox "A" Farm _____

Petroleum Inc. Company _____


Garvey Oil Contractor _____
Lincoln Pool

990 Ft. from N. Line

_____ Ft. from S. Line

990 Ft. from E. Line

_____ Ft. from W. Line

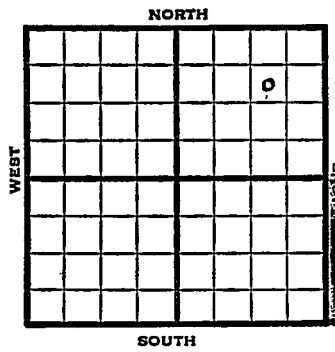

SW NE NE
MCPC has SW/33

1952 Elev. 1946' REPORT

- 1/2 RUR
- 1/4 " (Ltr)
- 1/11 Spudded 12-30-51
Set 8" @ 265'.
Drilling at 3100' "
- 1/17 Heeb 3297'
Br line 3413'
Lans. 3422'
DST 3542-54, open 1 hr., rec 30' OCM
& 150' water.
DST 3558-90, open 1 hr, rec 480'
water.
DST 3609-21, open 1 hr. rec 35' SOCM
Cong 3701' Viola 3709' Simp 3748'
Arb. 3806'
TD 3810' D & A (Ltr)
- 1/16 Spud 12-30-51
D & A TD 3810' 8" @ 265'
Heeb 3297' Br. line 3413' Lans 3422'
DST 3542-54, open 1 hr, rec 30' OCM
150' water.
DST 3558-90 open 1 hr, rec 480' water
DST 3609-21, open 1 hr, rec 35' SOCM
Cong. 3701' Viola 3709' Simp 3748'
Arb. 3806-10' TD
D & A

ABANDONED

