


Section 32 Township 21 Range 34W

Well No. 1 Hutchison

Company Michaelis Drlg.

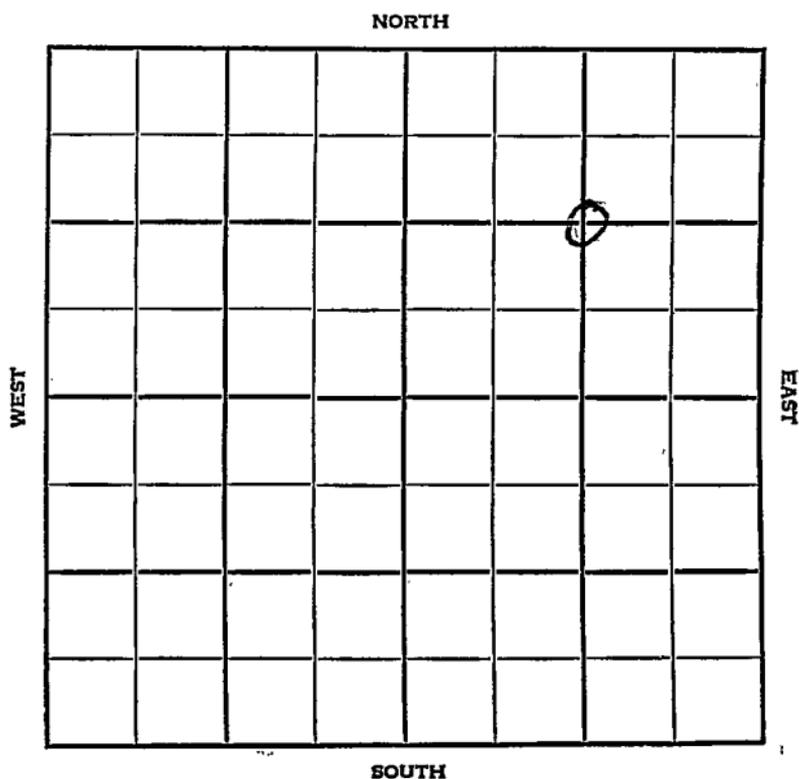

Finney

KANSAS

SEC. 32	TWP. 21	R.. 34W
------------	------------	------------

WELL NO. #1 Hutchinson FARM COMPANY

CONTRACTOR Michaelis Drlg.


Co. tools. Hugoton

_____ Ft. from N. Line

_____ Ft. from S. Line

_____ Ft. from E. Line

_____ Ft. from W. Line

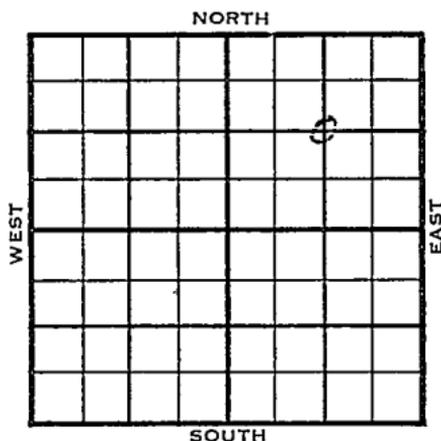

C NE/4

1955	ELEVATION	REPORT
	2992'	

7/6 Comm. 6-30-55
8" @ 298/250 TD 2619
5" @ 2617

7/28 Comm 6-30-55
Herr 2527, Kri 2558, Wfd 2611,
TD 2619
8" @ 298/250
5" @ 2617
72/2562-80 sd-frac 20/2531-36
frac 3 mcfg Comp 8,438 mcfgpd

COMPLETED

County Finney Elev. _____
 Sec. 32 Twp. 21 Rge. 34W
 Company Michaelis Drilg.
 Farm Name Hutchison No. I

Co.


TOPS	DEPTH	LOG	DATUM
Anh.			
Tp.			
H.			
Tr.			
Dg.			
Bl.			
L.			
K.C.			
B.K.C.			
Ce.			
C.			
M.			
M.			
K.			
Mz.			
Me.			
V.			
S.			
S.			
A.			
R.			
Pe.			
G.			
TD.			

Loc. in Sec. C NE/4

Geol. _____

Contr. Co. tools

Pool Hugoton

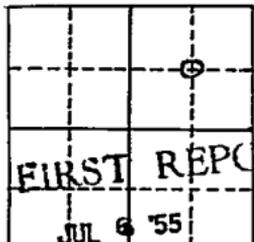

Lse.

No.

Date Comm. 6-30-55
8" @ 298/250 TD 2619 5" @ 2617

Sec.

T.

R.

Handwritten signature/initials

County Finney Elev. 2992
 Sec. 32 Twp. 21 Rgs. 34W
 Company Michaelis Drlg.
 FarmName Hutchinson No. 1

TOPS	DEPTH	LOG	DATUM	Loc. in Sec.
Anh. <u>Herr</u>		<u>2527</u>		<u>C NE/4</u>
Ep. <u>Kri</u>		<u>2558</u>		
H. <u>Wfd.</u>		<u>2611</u>		
Tr.				
Dg.				
Bl.				
L.				Geol.
K.C.				Contr.
B.K.C.				Co. tools
Ce.				Pool
C.				<u>Hugoton</u>
M.				
M.				
K.				
Mz.				
Ma.				
V.				
S.				
S.				
A.				
R.				
PE.				
G.				
T.D.	<u>2619</u>			

Date Comm. 6-30-55 JUL 27 1955

8" @ 298/250 5" @ 2617 72/ 2562-80

sd-frac 20/ 2531-36 frac 3 mcf/g

Comp. 8,438 mcf/gpd

Co.

Use.

No.

Sec.

T.

R.