


Section 33 Township 21 Range 12-W
 Well No. #1 Harris
 Company Petroleum Inc.

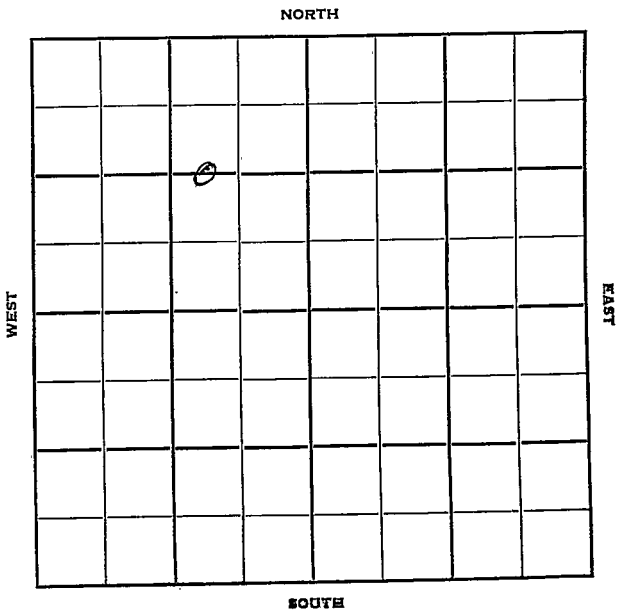

Stafford

KANSAS

Sec. 33 Twp. 21 R. 12W

Well No. #1 Harris Farm

Petroleum, Inc. Company

Contractor


1320' Ft. from N. Line

_____ Ft. from S. Line

990' Ft. from E. Line

_____ Ft. from W. Line

C W L E $\frac{1}{2}$ NW

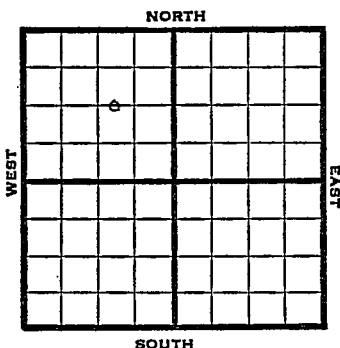

1950

Elev. 1862' REPORT

2/22

Spud 2-17-50
8" @ 287'
Drlg. 2075'

3/1

8" @ 287'
Heeb 3149'
Br L 3285'
Lans 3302'
Cong 3546'
TD. 3554'
D&A

ABANDONED

Map No. _____ Sec. 33 Twp. 21 R. 12WWell No. 1 Harris

_____ Petroleum Inc. _____

Company

_____ Contractor

C W L E $\frac{1}{2}$ NW1320 Ft. from N. Line


_____ Ft. from S. Line

990 Ft. from E. Line

_____ Ft. from W. Line

Stafford County

SECTION PLAT

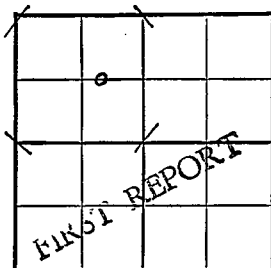

Location _____

Rig up _____

Drilling and Remarks:

Spud 2-17-50

8" @ 287

drlg. 2075

RECORD

Cased _____ in., _____ ft.

Sand _____

Gas _____

Oil _____

Total Depth _____

PRODUCTION

1st 24 hrs. Nat. _____

1st 24 hrs. after shot _____

Gas _____ Cu. Ft.

Dry Hole _____

Abandoned _____

Date

FEB 22 1950

19

J. E. TYRA

Scout

Kansas

Map No. _____ Sec. 33 Twp. 21 R. 12WWell No. 1 Harris

_____ Petroleum Inc. _____ Company

Contractor


C NW

E. 1862
SECTION PLAT1320 Ft. from N. Line

_____ Ft. from S. Line

990 Ft. from E. Line

_____ Ft. from W. Line

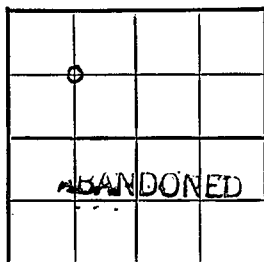

Stafford County

Location _____

Rig up _____

Drilling and Remarks:

8" @ 287Keel 3149Br L 3285Lane 3302Comp 3546-547 DD & A.

RECORD

Cased _____ in., _____ ft.

Sand _____

Gas _____

Oil _____

Total Depth 3554

PRODUCTION

1st 24 hrs. Nat. _____

1st 24 hrs. after shot _____

Gas _____ Cu. Ft.

Dry Hole _____

Abandoned _____

Date

MAR 1 1950J. E. TYRA19

Scout