


Stafford

KANSAS

Section 33 Township 2 21 Range 12-W

Well No. #1 Harris

Company Atlantic

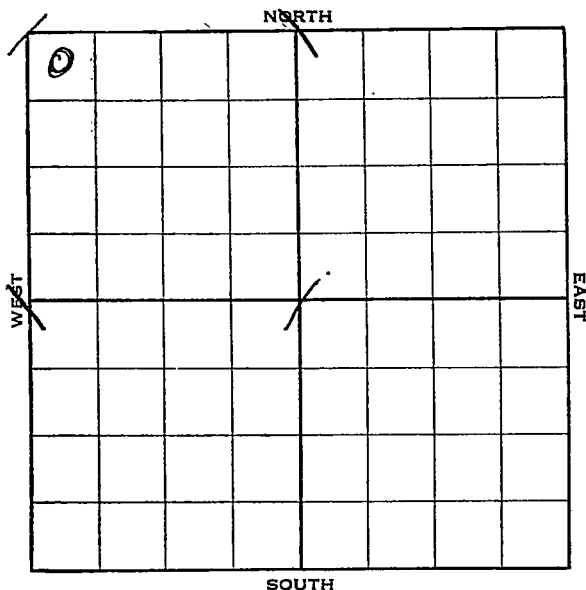

Sec. 33 Twp. 21 R. 12-W


Well No. #1 Harris Farm _____
Atlantic Company _____

330 Ft. from N. Line

_____ Ft. from S. Line

_____ Ft. from E. Line

330 Ft. from W. Line

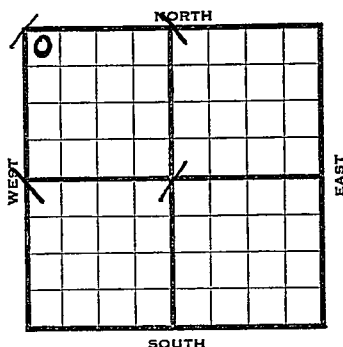

Elev. 1859

1938	REPORT
4/6	B.R.R.
4/15	R U R
4/22	10" @ 254'. Anhy 640'. Drlg. 1550'.
4/29	Drlg. 3220'.
5/6	Lans. 3267'. Viola 3540'. Simp. 3560'. S.O. 3628-30'. Arb. 3633'. S.O. 3635-41'.
5/12	T.D. 3658'. Rng. csg. 7" @ 3450'.
5/18	7" @ 3469'. Arb. 3633'. T.D. 3658'. P.B. 3430'.
	Perf. 40 shots. 3415-06'. No shows.
	1000 acid. H.F.W.
	ABANDONED

Stafford KANSAS

Map No. 46 Sec. 33 Twp. 21 R. 12W

Well No. 1 Harris

Atlantic

Company

Contractor

FIRST REPORT
NW/C

330 Ft. from N. Line

_____ Ft. from S. Line

_____ Ft. from E. Line

330 Ft. from W. Line

SECTION PLAT

0			

Location _____

Rig up _____

Drilling and Remarks:

BRR

RECORD

Cased _____ in., _____ ft.

Sand _____

Gas _____

Oil _____

Total Depth _____

PRODUCTION

1st 24 hrs. Nat. _____

1st 24 hrs. after shot _____

Gas _____ Cu. Ft.

Dry Hole _____

Abandoned _____

Date

APR 6 - 1938

19

H. D. Hatfield Scout

Stafford **KANSAS**Map No. 46 Sec. 33 Twp. 21 R. 12WWell No. 1 HarrisAtlantic

Company

Contractor

ABANDONED

NW/C

SECTION PLAT

330 Ft. from N. Line

_____ Ft. from S. Line

_____ Ft. from E. Line

330 Ft. from W. Line

0			

Location _____

Rig up _____

Drilling and Remarks:

P.B. 3430

Perf. 40 shots
3415-06

No shows

1000 Acid HFW

D+A

RECORD

Cased 7 in., 3469 ft.Sand ARB 3635

Gas _____

Oil _____

Total Depth 3658

PRODUCTION

1st 24 hrs. Nat. _____

1st 24 hrs. after shot _____

Gas _____ Cu. Ft.

Dry Hole _____

Abandoned _____

Date

MAY 18 1938 19

H. D. Hatfield

Scout