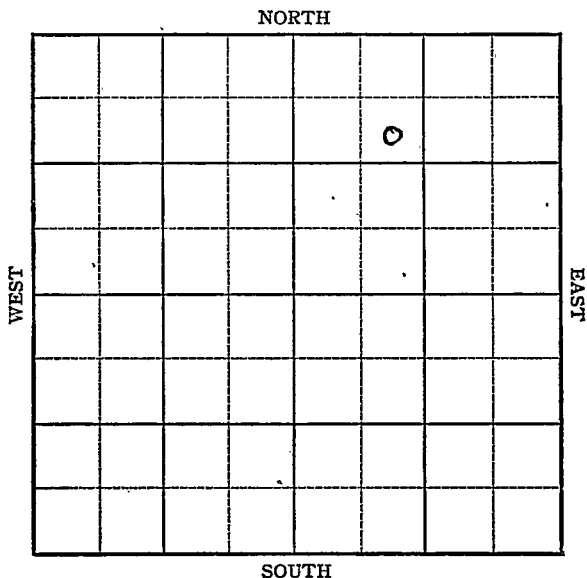


KANSAS

Stafford county

FORM 51, 5M 6-46 PETROL


Section 33 Township 21 Range 12-WWell No. #4, SittnerCompany Artmell

KANSAS

Stafford ✓

Sec. 33 Twp. 21-S R. 12-WWell No. #4 Sittner Farm
Artmell Company

990' Ft. from N. Line
____ Ft. from S. Line
____ Ft. from E. Line
990' Ft. from W. Line

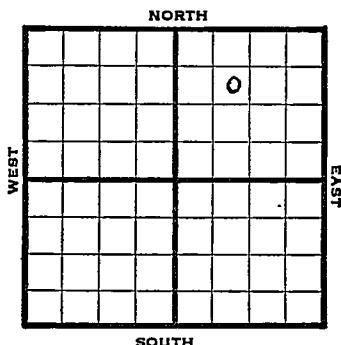

SE NW NE

1946 1855 REPORT

9/5 10" @ 320; anhy. 640; drlg. 1981
9/10 Lans 3268'
Drlg 3300'
9/18 Lans 3263'
Viola 3510
imp 3550'
Arb 3605-07 TD
5" @ 3606' RUST
9/24 TD3610'
3 BW plus BO PH
10/1 TD 3627'
PB 3608'
10/8 "
10/16 Arb 3605'
5" @ 3606'
TD 3627'
400 Acid
Pump 40 oil plus 75 W POT
Grav. 41

COMPLETED

Kansas Pool Name SittnerMap No. KANSAS Sec. 33 Twp. 21 R. 12WWell No. 4 SittnerArtmell Company

FIRST REPORT

Contractor

SE NW NE

SECTION PLAT

		o	

990 Ft. from N. Line Ft. from S. Line Ft. from E. Line990 Ft. from W. LineStafford CountyLocation Rig up

Drilling and Remarks:

10" @ 320

Anhy. 640

drlg. 1981

RECORD

Cased in., ft.Sand Gas Oil Total Depth

PRODUCTION

1st 24 hrs. Nat. 1st 24 hrs. after shot Gas Cu. Ft.Dry Hole Abandoned

Date

SEP 5 1946 19 S. J. LEWIS Scout

Kansas

Map No. 46 Sec. 33 Twp. 21 R. 12WWell No. 4 Sittner


Artmell

Company

COMPLETED

Contractor

SE NW NE

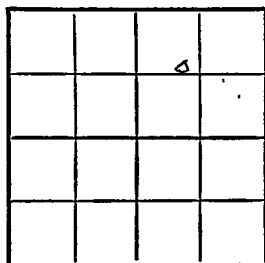E 11, 1835
SECTION PLAT990 Ft. from N. Line Ft. from S. Line Ft. from E. Line990 Ft. from W. Line

Stafford County

Location Rig up

Drilling and Remarks:

Cor 73605
 5' @ 3606
 400 corat
 Pump 40 oil +
 75 W P 8

41 2/3

RECORD

Cased in., ft.Sand Gas Oil Total Depth 3627

PRODUCTION

1st 24 hrs. Nat. 1st 24 hrs. after shot Gas Cu. Ft.Dry Hole Abandoned

Date

OCT 16 1946

19

S. J. LEWIS

Scout