
Stafford county

FORM 51 5M 6-46 KANSAS PETROL

Section 33 Township 21 Range 12-W

Well No. #5, Sittner

Company Artmell

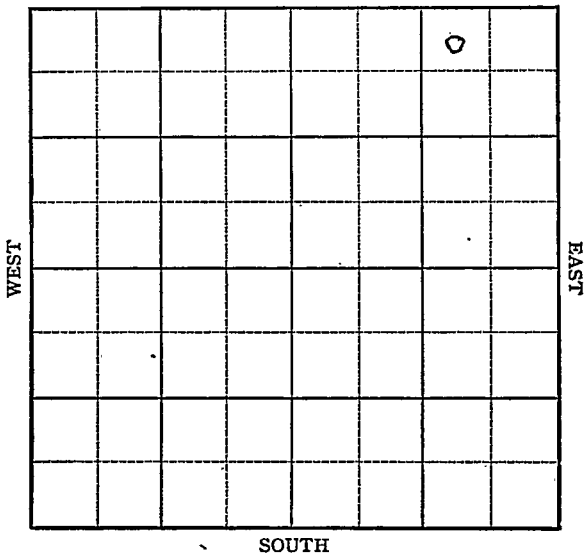

FORM 252-A
5M 12-45 PETROL KANSAS

Stafford County

Sec. 33 Twp. 21 R. 12W

Well No. #5 Sittner Farm

Artmell Company

Sittner


330 Ft. from N. Line

Ft. from S. Line

990 Ft. from E. Line

Ft. from W. Line

NW NE NE

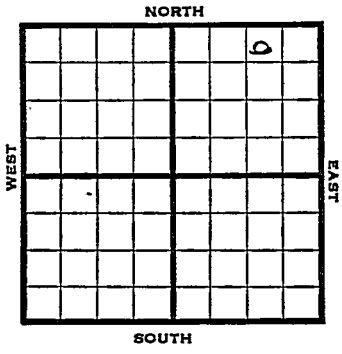

1946	1854 REPORT
9/18	RUR
9/24	10" @ 283' Anhy 655' Drlg 2891'
10/1	Lans 3272 BKC 3510' Cong 3510' Viola 3540' Simp 3594 Arb 3636' Drlg 3794'
10/8	TD 3868' 5" @ 3867, SWD
10/15	" "
10/22	" "
10/30	Arb 3636' 5" @ 3867' TD 3868' SWD ABANDONED

FORM 26 200 BKS. 2-44 PETROL

KANSAS - Kansas Pool Name Sittner

Map No. 46 Sec. 33 Twp. 21 R. 12W

Well No. 5 Sittner

Artmell Company

FIRST REPORT Contractor

NW NE NE


330 Ft. from N. Line

Ft. from S. Line

990 Ft. from E. Line

Ft. from W. Line

SECTION PLAT

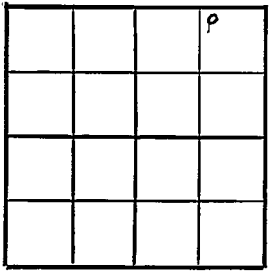

Stafford County

Location

Rig up

Drilling and Remarks:

R U R

RECORD

Cased in., ft.

Sand

Gas

Oil

Total Depth

PRODUCTION

1st 24 hrs. Nat.

1st 24 hrs. after shot

Gas Cu. Ft.

Dry Hole

Abandoned

Date

SEP 1 8 1946 19

S. J. LEWIS Scout

Sittner Pool

Form 26 200 Bks. 10-46 Petrol

Kansas

Map No. 46 Sec. 33 Twp. 21 R. 12W

Well No. 5 Sittner


Artmell Company

ABANDONED Contractor

NW NE NE

E1,854

SECTION PLAT

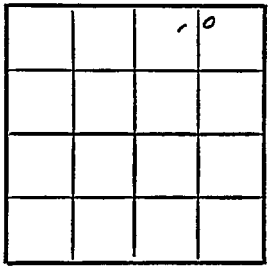

330 Ft. from N. Line

Ft. from S. Line

990 Ft. from E. Line

Ft. from W. Line

Stafford County

Location

Rig up

Drilling and Remarks:

Cr 3686

5"@3867

SWD

RECORD

Cased in., ft.

Sand

Gas

Oil

Total Depth 3868

PRODUCTION

1st 24 hrs. Nat.

1st 24 hrs. after shot

Gas Cu. Ft.

Dry Hole

Abandoned

Date

OCT 30 1946 19

S. J. LEWIS Scout