
FORM 51 5M 2-38 TPCO. Stafford KANSAS

Section 33 Township 21 Range 12-W

Well No. 1 Max Sittner

Company Stanolind

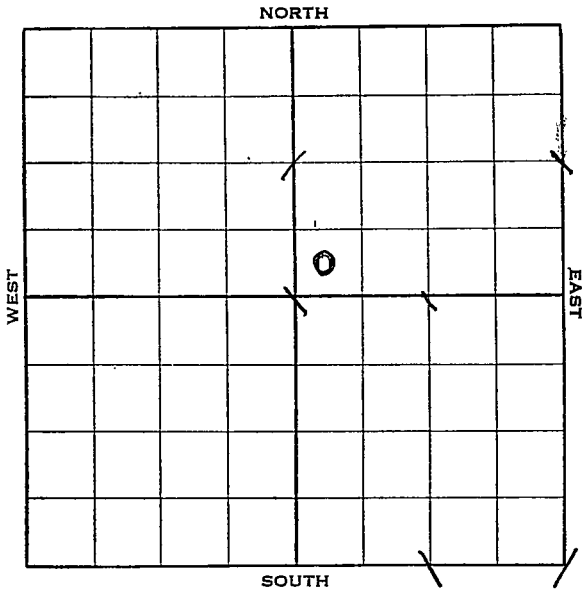


Form 252-A—5M—9-37 KANSAS Stafford

Sec. 33 Twp. 21 R. 12-W

Well No. #1 Max Sittner Farm

Stanolind Company

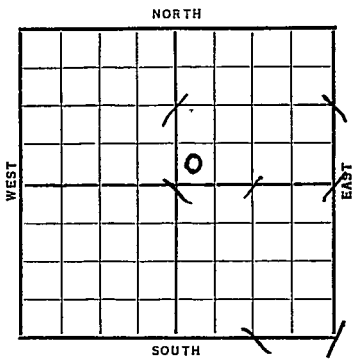

____ Ft. from N. Line

330 Ft. from S. Line

____ Ft. from E. Line

330 Ft. from W. Line

Elev. 1855

Date	REPORT
~~1938~~	
~~3/9~~	~~R.R.~~
3/18	10" @ 250'. Drlg. 1055'.
3/25	Drlg. 3290'.
4/1	K.C. 3290'. Viola 3520'.
	Simp. sh. 3555'. Arb. 3612'.
	T.D. 3615'. Sat. Core.
	6" @ 3612'. RUST.
4/8	T.D. 3620'. 1500' oil.
	2000 acid. Swab 150 oil in 2
	hrs. 1700' off bottom.
4/15	On potential.
4/20	6" @ 3612'.
	Arb. 3612'.
	T.D. 3620'.
	2000 acid.
	Potential 1764 bbls.
	COMPLETED

Form 26—1M Bks.—2-29 Stafford KANSAS

Map No. 46 Sec. 33 Twp. 21 R. 12W

Well No. 1 Max Sittner

Stanolind Company

Contractor

FIRST REPORT

SW NE


Ft. from N. Line

330 Ft. from S. Line

Ft. from E. Line

330 Ft. from W. Line

SECTION PLAT

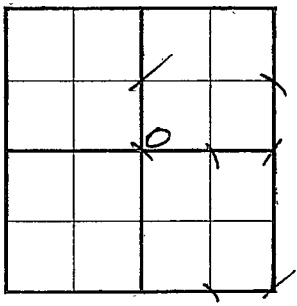

Location

Rig up

Drilling and Remarks:

RR

RECORD

Cased in., ft.

Sand

Gas

Oil

Total Depth

PRODUCTION

1st 24 hrs. Nat.

1st 24 hrs. after shot

Gas Cu. Ft.

Dry Hole

Abandoned

Date

MAR 9 - 1938 19 H. D. Hatfield Scout

Form 26—1M Bks.—2-29

Stafford KANSAS

Map No. 46 Sec. 33 Twp. 21 R. 12W

Well No. 1 Max Sittner

Stanolind Company

Contractor

COMPLETED

SW NE


Ft. from N. Line

330 Ft. from S. Line

Ft. from E. Line

330 Ft. from W. Line

SECTION PLAT

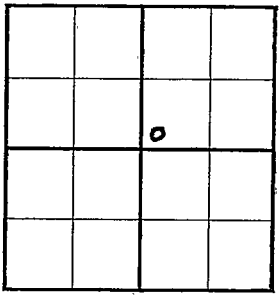

Location

Rig up

Drilling and Remarks:

2000 acid

Pot 1764

RECORD

Cased 6 in., 3612 ft.

~~Sand~~ Arb 3612

Gas

Oil

Total Depth 3620

PRODUCTION

1st 24 hrs. Nat.

1st 24 hrs. after shot

Gas Cu. Ft.

Dry Hole

Abandoned

Date

APR 20 1938 19

H. D. Hatfield Scout