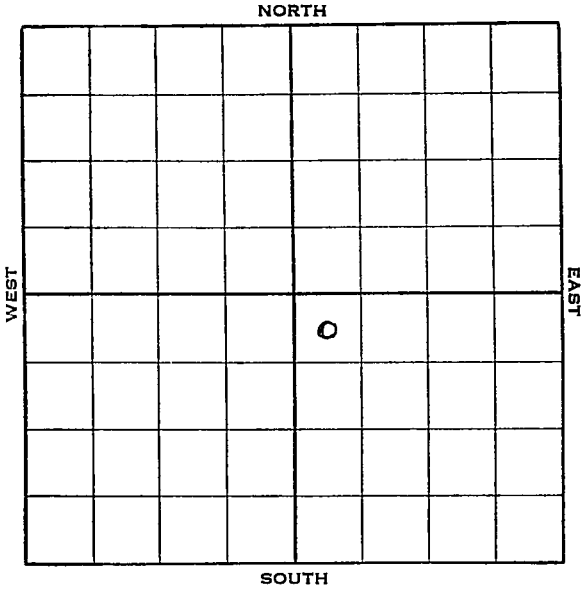


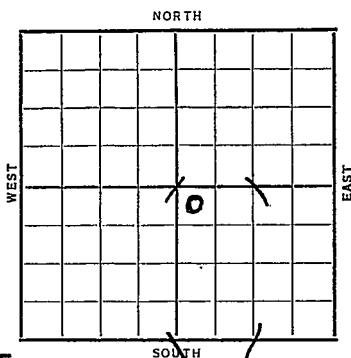
Stafford

Section 33 Township 21 Range 12-W
Well No. 1 Max Sittner
Company Royal O & G. Corp.



KANSAS

Stafford

Sec. 33 Twp. 21 R. 12-WWell No. #1 Max Sittner Farm
Royal O & G Corp. Company330 Ft. from N. Line Ft. from S. Line Ft. from E. Line330 Ft. from W. LineElev. ~~1866~~ 1865

Date

REPORT

1938

2/16 10" @ 274'. Drlg. 2080'.

2/26 Drlg. 3010'.

3/4 Lans. 3296'. Drlg. 3590'.

No shows reported.

3/11 Viola 3530'. Simp. shale 3560'.

Arb. 3622', T.D. 3627'. S.O.

3/18 7" @ 3622'. Cleaning out.

3/23 7" @ 3622'.

Arb. 3622'.

T.D. 3630'.

Potential 1307 bbls.

COMPLETED

Stafford KANSAS

Map No. _____ Sec. 33 Twp. 21 R. 12WWell No. 1 Max SittnerRoyal O & G Corp.

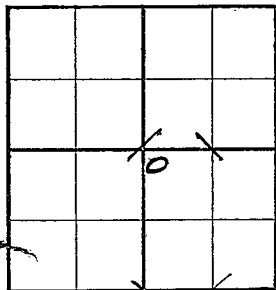
Company

Contractor

FIRST REPORT

NW SE

SECTION PLAT

330 Ft. from N. Line

_____ Ft. from S. Line

_____ Ft. from E. Line

330 Ft. from W. Line

Location _____

Rig up _____

Drilling and Remarks:

10" - 274Dr1g. 2080

RECORD

Cased _____ in., _____ ft.

Sand _____

Gas _____

Oil _____

Total Depth _____

PRODUCTION

1st 24 hrs. Nat. _____

1st 24 hrs. after shot _____

Gas _____ Cu. Ft.

Dry Hole _____

Abandoned _____

Date

FEB 16 1938H. D. Hatfield19

Scout

Map No. 46 Sec. 33 Twp. 21 R. 12WWell No. 1 Max SittnerRoyal Oil & Gas Corp. Company

Contractor

COMPLETED

NW SE

330 Ft. from N. Line Ft. from S. Line330 Ft. from E. Line Ft. from W. Line

SECTION PLAT

		0	

Location Rig up

Drilling and Remarks:

Pot 1307

RECORD

Cased 7 in., 3622 ft.Sand Arb 3622Gas Oil Total Depth 3630

PRODUCTION

1st 24 hrs. Nat. 1st 24 hrs. after shot Gas Cu. Ft.Dry Hole Abandoned

Date

MAR 23 1936H. D. Hatfield19

Scout