

KANSAS

Form 51-5M-7-40-Palace


Stafford

Section 33 Township 21 Range 12-W

Well No. #2 Walker

Company Stanolind

NORTH Sittner Pool

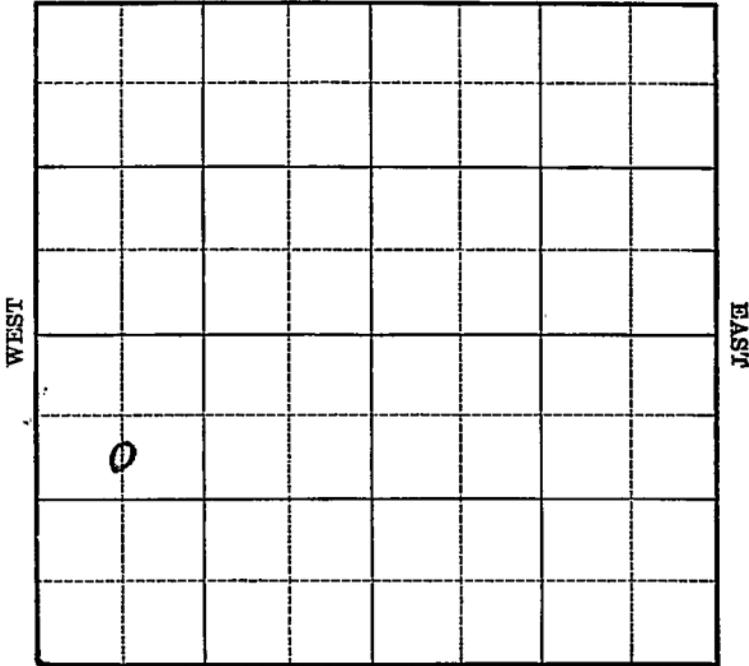

SOUTH

Sec. 33 Twp. 21 R. 12-W

Well No. #2 Walker Farm

Stanolind Company

(Sittner)


990 Ft. from N. Line

_____ Ft. from S. Line

_____ Ft. from E. Line

660 Ft. from W. Line

Elev. 1881

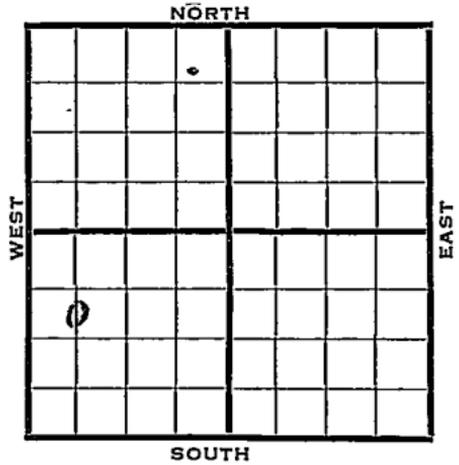

1941	REPORT
1/22	Location
1/30	"
2/6	"
2/13	"
2/20	"
2/27	"
3/6	"
3/13	Derrick.
3/20	"
3/27	"
4/3	8" - 285' Drlg. 400'
4/10	Anhy 667' Drlg. 330.8'
4/18	Lans. 3300' Viola 3545'
	Simp. 3590' Arb. 3645-49' T.D.
	S.O. 5" - 3645' RUST.
4/24	3500 acid. Testing.
	OVER

1941

4/30

Viola 3545'

Arb. 3645'

5" - 3645'

T.D. 3649'

800 acid.

Pump 98 oil plus 19% water.

37.6 Gravity

COMPLETED

Map No. 46 Sec. 33 Twp. 21 R. 12WWell No. 2 WalkerStanolind

Company

Contractor

FIRST REPORT

C S L NW SW

990 Ft. from N. Line

_____ Ft. from S. Line

_____ Ft. from E. Line

660 Ft. from W. Line

SITTNER POOL

SECTION PLAT

Location &

Rig up _____

Drilling and Remarks:

RECORD

Cased _____ in., _____ ft.

Sand _____

Gas _____

Oil _____

Total Depth _____

PRODUCTION

1st 24 hrs. Nat. _____

1st 24 hrs. after shot _____

Gas _____ Cu. Ft.

Dry Hole _____

Abandoned _____

Date

JAN 22 1941

19

S. J. LEWIS Scout

Misc. Small Maps *Paul*
Cards *Paul*
Tracing *Joe*
France Map *Paul*
Scarborough Map *Paul*
Moody Map *Paul*
Geological Dept.
Moody Flat Book

Map No. 46 Sec. 33 Twp. 21 R. 12WWell No. 2 WalkerStanolind

Company

COMPLETED

Contractor

SECTION PLAT

C S L NW SW

990 Ft. from N. Line

_____ Ft. from S. Line

_____ Ft. from E. Line

660 Ft. from W. Line

SITTNER Pool

Location _____

Rig up _____

Drilling and Remarks:

Vidla 3545
Dr 3645
5" @ 3645
800 acid
Pump. 9 Soil +
19% Water
376 SW

RECORD

Cased _____ in., _____ ft.

Sand _____

Gas _____

Oil _____

Total Depth 3649

PRODUCTION

1st 24 hrs. Nat. _____

1st 24 hrs. after shot _____

Gas _____ Cu. Ft.

Dry Hole _____

Abandoned _____

Date

APR 30 1941

19

S. J. LEWIS

Scout

Misc. Small Maps	<i>BAAD</i>
Cards	<i>gn</i>
Tracing	<i>gn</i>
France Map	<i>gn</i>
Scarborough Map	<i>gn</i>
Moody Map	<i>gn</i>
Geological Dept.	
Moody Plat Book	