


Section 33 Township 21 Range 13W

Well No. 1 Gates "G"

Company Derby Drlg.

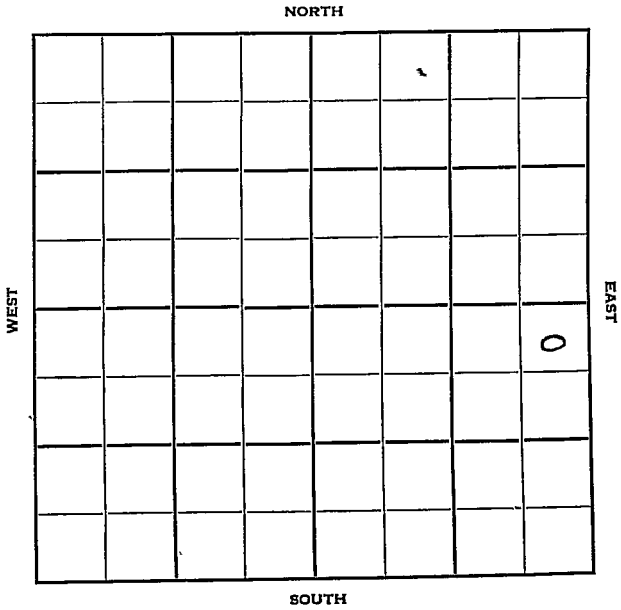



33

21

13W

Sec. _____ Twp. _____ R. _____

#1 Gates "C"

Well No. _____ Farm _____

Derby Drlg.

Company _____

Rockett Drlg.

Contractor _____

Gates Pool

330

Ft. from N. Line


Ft. from S. Line

330

Ft. from E. Line

Ft. from W. Line

NE NE SE

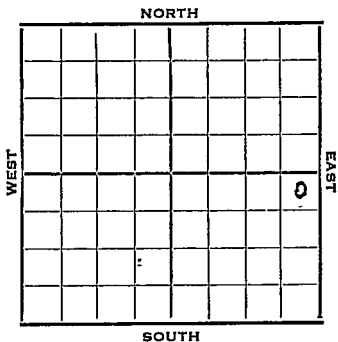

1952

Elev. 1891' REPORT

12/10 Spud 12-3-52
8" @ 275
Anhy 734
Drlg. 3115'

12/11 Ø3115

12/18 Heeb 3226 Br 1 3356 Lans 3366 DST 3393
3448 1 Hr. 400' GCM & SW 1260# DST
3503-38 1½ Hr. 65' V SOCM 970# Cong
3638 V 3642 Simp 3674 Simp Sd 3688
ARB 3726 RTD 3729 5" @3727 RUST

12/23 Spud 12-3-52
Oil well TD 3733' 8" @ 275
Anhy 734' Heeb. 3226' Br. lime 3356
Lans. 3366'
DST 3393-3448 open 1 hr. rec 400' GCM
& SW, 1260#
DST 3503-38 open 1½ hr. rec 65' VSOCM
970# Cong. 3638' Viola 3642'
Simp. 3674' Simp. sd, 3688', Arb. 3726
TD 3729' 5" @ 3727' DD 3730'
FU 120' oil 1 hr. DD 3733 10-12 BOPH
Comp. 50 BOPD

COMPLETED

