


Section 33 Township 21 Range 13 W

Well No. # 6 Stafford

Company Phillips Pet.

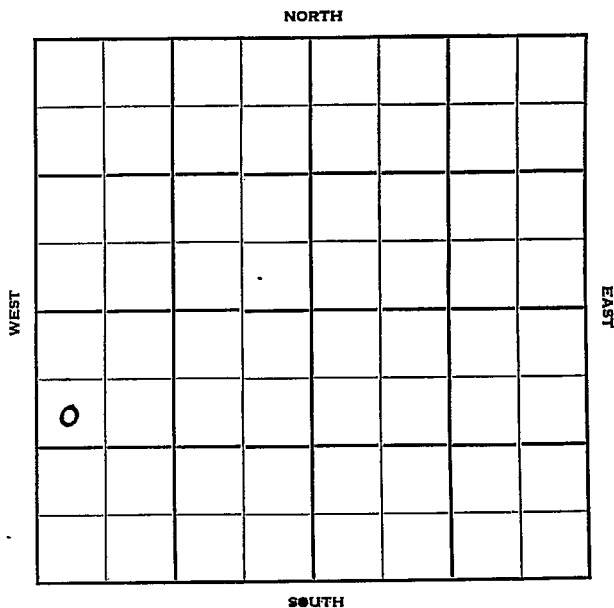

Stafford

KANSAS

Sec. 33 Twp. 21 R. 13W

Well No. #6 Stafford Farm

Phillips Pet. Company

Stagg Contractor


990 Ft. from N. Line

_____ Ft. from S. Line

_____ Ft. from E. Line

330 Ft. from W. Line

SW NW SW

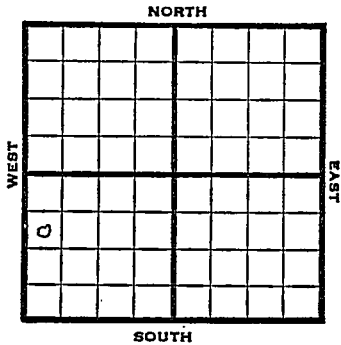

1952 Elev. 1901' REPORT

2/13 RUR
 2/20 8" @ 304'
 Drlg. 2890'

3/5 CO 3615 20/3595-2600
 24/3600-3606 West SSO&W 1000 A
 F 79 BO & 5 BW 1 hr. F 334 BO &
 1% wtr 11½ hrs. G 28
 Set plug 3585 72/3555-73
 F 85 BO 3½ hrs.
 68/3532-49 F 140 BO 6½ hrs.
 Set plug 3528

3/12 48/3512-24 56/3491-3505
 F 306 BO 10 hrs DO to 3613
 2000 A F 480 BO & trace wtr
 23 hrs. 1/2"ck.

3/19 F 57 BO 2½ hrs. died.

4/2 Spud 2-13-52
 Oil Well TD 3613
 8" @ 304'
 Heeb. 3225 Br Li 3352
 Lans. 3361 B KC 3594
 TD 3627 5" @ 3625 CO to 3615
 20/ 3595-3600 24/ 3600-3606
 B/ 1 qt. oil 3 gw 1 hr. 1000 A
 F/ 79 bo 5 bw 1 hr. F/ 334 bo
 plus 1% wtr. 11½ hr. SP 3585

OVER

1952

4/2 48/ 3512-24 56/ 3491-3505
F/ 306 bo IO hr. 2% wtr. DD
3613 2000 A F/ 480 BO tr. wtr.
23 hr. F/ 57 bo 2½ hr.
Comp. BHB 3000 bopd

COMPLETED

Scout Cards *mt*
Land Small Map
Land Wall Map *3*
Tracings
France Map
Pierce Map
Misc.

FEB 15 1952

Scout Cards	35
Land Small Map	
Land Wall Map	3
Tracings	
France Map	
Pierce Map	
Misc	

APR 8 1952