

KANSAS

Stafford

Section 33 Township 21 Range 13WWell No. 1 HuffordCompany Phil-Han

0							

Wildcat NORTH

WEST EAST

SOUTH

Stafford

✓

KANSAS

Sec. 33 Twp. 21 R. 13W

Well No. #1 Hufford Farm

Phil-Han Company

Wildcat


 Ft. from N. Line

330' Ft. from S. Line

 Ft. from E. Line

330' Ft. from W. Line

SW NW

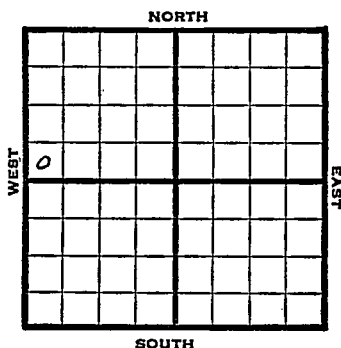

1948 Elev. 1903' REPORT

3/3	Location
3/10	"
3/17	"
3/24	8" @ 300' Drlg. 2493'
3/31	Lansing 3382' Drlg. 3600'
4/7	Conglomerate 3655' Viola 3661' Simpson 3698' Arbuckle 3755' 5" @ 3755' TD 3770' Swb. 9 bbls. oil PH 100' off bottom.
4/14	Swb 10 bbls oil PH, 10 hrs.
4/21	Arbuckle 3755' 5" @ 3755' Pump 368 Pot. Gr. 30° TD 3770' COMPLETED

Map No. _____ Sec. 33 Twp. 21 R. 13W

Well No. 1 Hufford

Phil-Han Company

FIRST REPORT Contractor

SW NW

SECTION PLAT

_____ Ft. from N. Line

330 Ft. from S. Line

_____ Ft. from E. Line

330 Ft. from W. Line

Stafford County

Location X

Rig up _____

Drilling and Remarks:

RECORD

Cased _____ in., _____ ft.

Sand _____

Gas _____

Oil _____

Total Depth _____

PRODUCTION

1st 24 hrs. Nat. _____

1st 24 hrs. after shot _____

Gas _____ Cu. Ft.

Dry Hole _____

Abandoned _____

Date


MAR 3 1948 19 _____ S. J. LEWIS Scout

Map No. 82 Sec. 33 Twp. 21 R. 13WWell No. 1 HuffordPhil-Han Company

COMPLETE

Contractor

SW NW

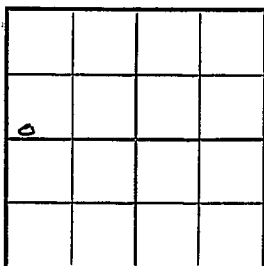E. I. 1903
SECTION PLAT Ft. from N. Line330 Ft. from S. Line Ft. from E. Line330 Ft. from W. Line

Stafford County

Location Rig up

Drilling and Remarks:

Aug 37555" 3755Prod 36800830° E

RECORD

Cased in., ft.Sand Gas Oil ✓Total Depth 3770

PRODUCTION

1st 24 hrs. Nat. 1st 24 hrs. after shot Gas Cu. Ft.Dry Hole Abandoned

Date

APR 21 1948 19 S. J. LEWIS Scout