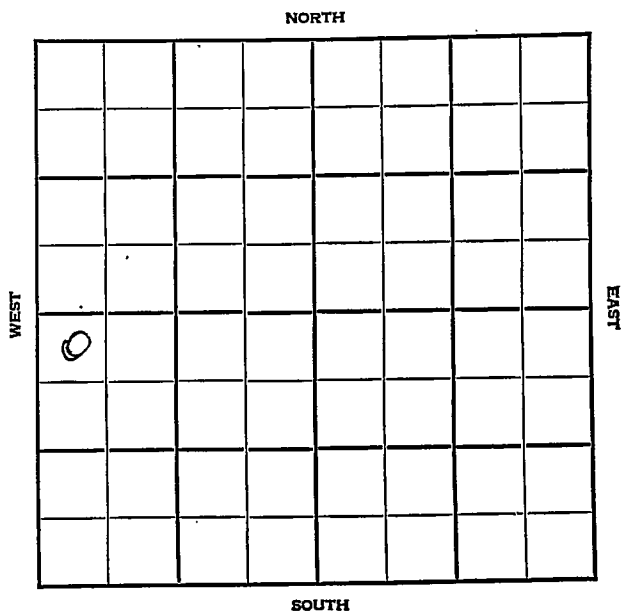


Stafford

KANSAS

Section 33 Township 21 Range 13WWell No. 1 StaffordCompany Phillips

Sec. 33 Twp. 21 R. 13W

Well No. #1 Stafford Farm

Phillips Company

Hufford


330 Ft. from N. Line

Ft. from S. Line

Ft. from E. Line

330 Ft. from W. Line

NW SW

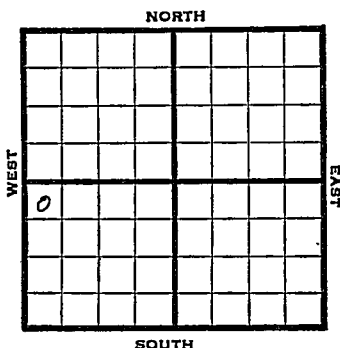

1948

E1 1903'

R E P O R T

4/28

Location

5/5

8" @ 451'

Drlg. 2405'

5/12

Lansing 3372'

Drlg. 3524'

5/19

Viola 3554'

Simpson 3692'

Arbuckle 3753'

TD 3755'

5" @ 3754'

RUST

5/26

"

6/1

"

6/9

TD 3761'

Swb 405 bbls oil 12 hrs.

6/16

"

6/23

TD 3761'

Arb. 3753'

5"@ 3754'

Echo Pot 3000 oil

39° Gr

Comp

COMPLETED

Map No. _____ Sec. 33 Twp. 21 R. 13W

Well No. 1 Stafford

Phillips Company

FIRST REPORT

Contractor _____

NW SW


.SECTION PLAT

330 Ft. from N. Line

_____ Ft. from S. Line

_____ Ft. from E. Line

330 Ft. from W. Line

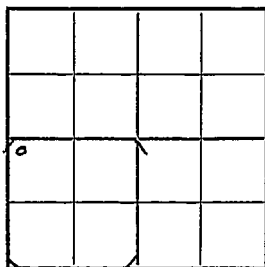

Stafford County

Location X

Rig up _____

Drilling and Remarks:

RECORD

Cased _____ in., _____ ft.

Sand _____

Gas _____

Oil _____

Total Depth _____

PRODUCTION

1st 24 hrs. Nat. _____

1st 24 hrs. after shot _____

Gas _____ Cu. Ft.

Dry Hole _____

Abandoned _____

Date

APR 28 1948 19 S. J. LEWIS Scout

Map No. 82 Sec. 33 Twp. 21 R. 13WWell No. 1 StaffordPhillips

Company

COMPLETE

Contractor

NW SW

E. I. 1903
SECTION PLAT330 Ft. from N. Line Ft. from S. Line Ft. from E. Line330 Ft. from W. Line

4			

Stafford CountyLocation Rig up

Drilling and Remarks:

etc

*39 1/2 ft***RECORD**Cased in., ft.Sand Gas Oil Total Depth 3761**PRODUCTION**1st 24 hrs. Nat. 1st 24 hrs. after shot Gas Cu. Ft.Dry Hole Abandoned

Date

JUN 23 194819S. J. LEWIS

Scout