


Section 33 Township 21 Range 13W

Well No. #6 Gates

Company B & B Drlg.

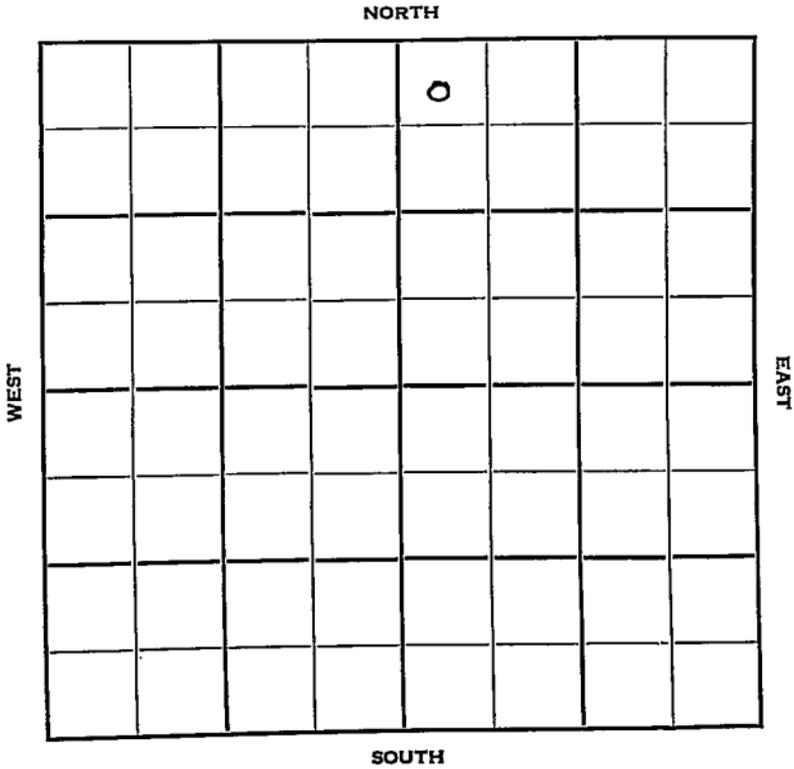

Sec. 33 Twp. 21 R. 13 W

Well No. # 6 Gates Farm

B & B Drlg. Company

Contractor

Gates


330 Ft. from N. Line

Ft. from S. Line

Ft. from E. Line

330 Ft. from W. Line

NW NW NE

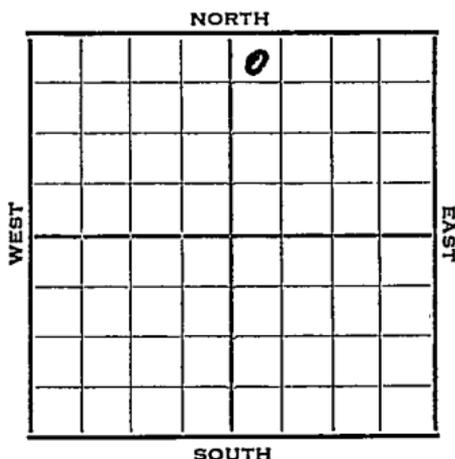

1952 Elev. 1903' REPORT

10/29 RUR

11/5 8" @ 215
Anhy 750', Heeb 3240', Lans
3380'
Drlg. 3460'

11/12 Spud 10-28-52
D&A
TD 3795
8" @ 215
Anhy 750, Heeb. 3240, Lans
3380, Viola 3645, Simp 3705,
Arb 3792
TD 3795
D&A

ABANDONED

County **Stafford** State **Kansas**

Sec. **33** (Blk. Twp.) **21** (Sur. Rge.) **13W** Map No.

Operator **B & B Drlg.**

Well No. **6** Farm **Gates**

Elev. Location **NW NW NE**

330 Ft. From **N** Line **NE**

330 Ft. From **W** Line **Quarter**

1st. Report **OCT 29 1952**

Completion

Remarks

Spudding Date

Drlg. Data **Gates Pool**

RUR

