

Section 33 Township 21 Range 13 WWell No. # 7 StaffordCompany Phillips Pet.

NORTH

0							

WEST

EAST

SOUTH

Stafford

KANSAS

Sec. 33 Twp. 21 R. 13 W ✓

Well No. # 7 Stafford Farm

Phillips Pet. Company

Stag Contractor


 Ft. from N. Line

330 Ft. from S. Line

 Ft. from E. Line

330 Ft. from W. Line

SW SW SW

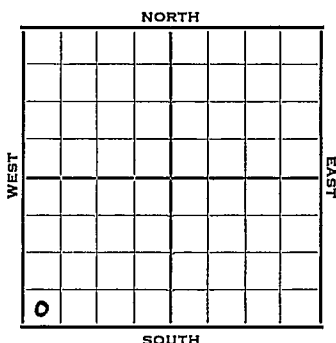

1952

Elev. 1902' REPORT

2/27

Spud 2-25-52
8" @ 302'

3/5

Drlg: 3206'

3/12

Spud 2-25-52
D & A TD 3860' 8" @ 302
Heeb 3249' Tor. 3271' Br. 11 3382'
Lans. 3393' Cong. 3681' Viola 3684'
DST 3681-95 open 2 hr, rec 245' SW
Arb. 3825' TD 3860' D & A

ABANDONED

County Stafford State KansasSec. 33 (Blk. 21 (Sur. 13W Map No. 21) (Rge.)Operator Phillips Pet.Well No. 7 Farm StaffordElev. Location SW SW SW

0									

330 Ft. From S Line330 Ft. From W Line quarter1st. Report FEB 27 1952Completion Remarks Stag - Contr.Spudding Date 2-25-52Drlg. Data 8" @ 302J. G. McGEHEE

County Stafford State
 Sec. 33 (Blk.) 21 (Sur.) 13W Map No.
 (Twp.) (Rge.)

Operator Phillips Pet.

Well No. 7 Farm Stafford

Elev. 1902 Location SW SW SW



330 Ft. From S Line SW

330 Ft. From W Line Quarter

1st. Report

Completion MAR 1 2 1952

Remarks

Stagg Drlg. - Contr.

Spudding Date 2-25-52

Drlg. Data D & A TD 3860

8" @ 302 Heeb. 3249 Tor. 3271

Br. lime 3382 Lans. 3393 Cong. 3681

Viola 3684 DST 3681-95 open 2 hr.

Rec. 245' sw Arb. 3825 TD 3860

D & A