


Section 33 Township 21 Range 14W

Well No. #2 Strobel

Company Hilton Drlg.

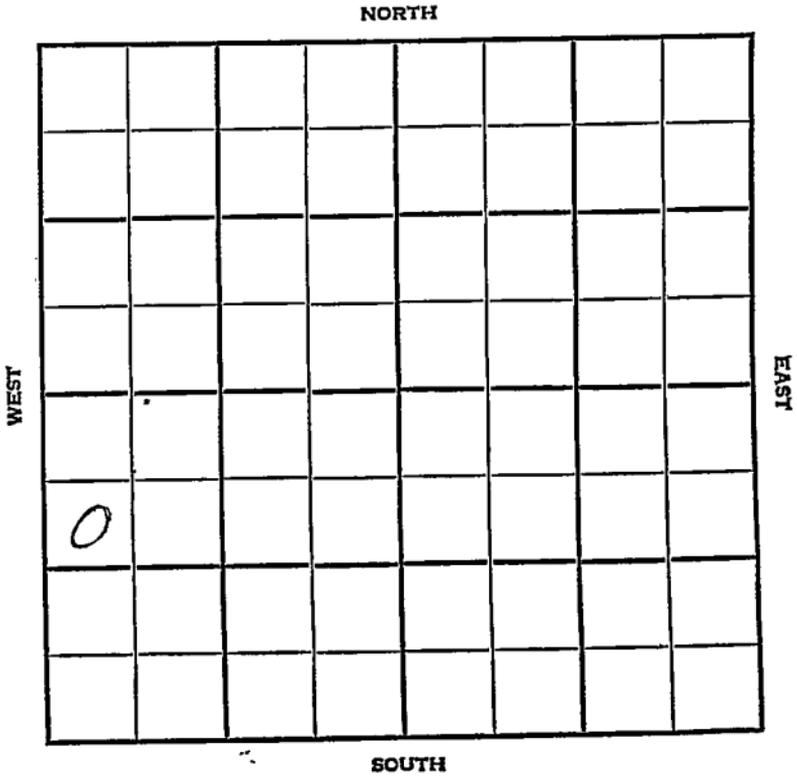

County Stafford Elev. _____
 Sec. 33 Twp. 21 Rgs. 11W
 Company Hilton Drlg.
 FarmName Strobel No. 2

TOPS	DEPTH	LOG	DATUM
Anh.			
Tp.			
H.			
Tr.			
Dg.			
Bl.			
L.			
K.C.			
B.K.C.			
Ce.			
C.			
M.			
M.			
K.			
Mz.			
Mo.			
V.			
S.			
S.			
A.			
R.			
PE.			
G.			
T.D.			

Loc. in Sec. _____

SW NW SW

Geol. _____

Contr. _____

Co. roots

Pool LINCOLN

Radium Test _____

FIRST REPORT	
DEC	5 '26

Date Comm. _____

M I R

(Handwritten signature)

Co.

Lse.

No.

Sec.

T.

R.

County Stafford Elev. 1744
 Sec. 33 Twp. 21 Rge. 11W
 Company Hallon Drlg.
 Farm Name Strobel No. 2

TOPS	DEPTH	LOG	DATUM
Anh.	872		
Tr.	3315		
Dg.			
Bl.	3433 3443		
L.	3442 3452		
K.C.			
B.K.C.	3680		
Ce.			
C.	3712		
M.			
M.			
K.			
Mz.			
Mo.			
V.	3741		
S.	3794		
S.			
A.	3854		
R.			
PE.			
G.			
T.D.	3905		

Loc. in Sec. SW-NW-SW
 Geol. 1100
 Contr. 1100
 Co. tools new pay
 Pool (Viola)
 Radium Test.

COMPLETE

JAN 23 '57

Date Comm.

M I R DEC 12 '56 12-3-56 878 285'
 1200 D 3342 DEC 17 '56 DST 3563
 -76 or 90" G/23" net 930'
 oil BHP 750/20" DST 3745
 -54 90" G/24" net 3623' 9554
 oil FP 200-1100 BHP 1250/20
 5 1/2 3903 / MICT DEC 26 '56 CO 16/
 3868-72 550 1 1/2 & 4.68 BFph
 & 27 D0 390 wti no time

Co.
 Lse.
 No.
 Sec.
 T.
 R.

PB 3785 30/3744-49 A

15 BFPH 2/1090 B&S T&R

JAN 2 '57

JAN 5 "

JAN 1 "

POP

JAN 23 '57

Ph P. 198 Bopd no/w

graw. 38°

Scout records show #1 well reported SW NW NW,
then corrected and completed as SW NW SW.

You show this #2 well first reported as SW NW SW
and completed as SW NW SW.

Will you please check your records and please
advise if these are correct? Thanks.
Also, please advise how many well in SW/4 Sec. 33
Sam Baird