

Stafford

KANSAS

SECTION 33 TOWNSHIP 21 RANGE 14WWELL NO. #1 CoxCOMPANY Buick Drlg. Co.

		NORTH				SW SW NW			
WEST									EAST
	0								
		SOUTH							

Stafford KANSAS

SEC.	TWP.	R.
33	21 S	14 W

WELL NO. # 1 Cox FARM

COMPANY Buick Drlg. Co.

CONTRACTOR Co. tools


Radium Towniste

_____ FT. FROM N. LINE

_____ FT. FROM S. LINE

_____ FT. FROM E. LINE

_____ FT. FROM W. LINE

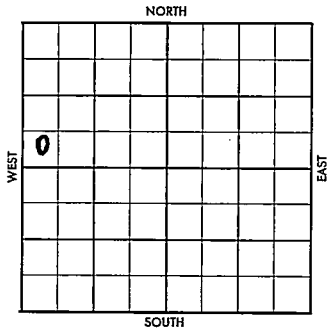

SW SW NW

SDX-Offset Prod.

1957	ELEVATION	REPORT
------	-----------	--------

2/13	RUR	(FR Tkt)
------	-----	----------

County Stafford

Elev. _____

Sec. 33Twp. 21Rge. 14WCompany Buick Drlg. Co.FarmName CoxNo. 1

TOPS

DEPTH

LOG

DATUM

Loc. in Sec. _____

Anh. _____

Tp. _____

H. _____

Tr. _____

Dg. _____

BL. _____

L. _____

K.C. _____

B.K.C. _____

Ce. _____

C. _____

M. _____

M. _____

K. _____

Mz. _____

Mq. _____

V. _____

S. _____

S. _____

A. _____

R. _____

PE. _____

G. _____

T.D. _____

SW SW NW

Geol. _____

Contr. _____

Co. Tools _____

Pool LINCOLN

Radium Townsite

FIRST REPORT

Offset _____

FEB 13 '57

Date Comm. _____

RUR Sunray no longer has the
 Sw'4 of Section 33 leased

13

County StaffordElev. 1944Sec. 33Twp. 21Rge. 14WCompany Buick Drlg. Co.Farm Name CoxNo. 1

	DEPTH	LOG	DATUM
R.	373		
Tr.	3326		
Dg.			
BL.	3445		
L.	3454		
K.C.			
B.K.C.	3692		
Ce.			
C.	3726		
M.			
M.			
K.			
Mz.			
Mo.			
V.	3758		
S.	3828		
S.			
A.	3882		
R.			
Pe.			
G.			
T.D.	3892		

Loc. in Sec.

SW SW NW

Geol.

Contr.

Co. Tools

Pool LINCOLN

Radium Townsite

ABANDONED

MAR 6 '57

OFFSE 1/2

Date Comm.

R U R FEB 27 '57 2-13-57 8578

283/182 M 2505 FEB 27 '57

DST 3568-90 90" 33' Md (SSO)

FPO BHP 110/20" CIRC @ 3762

MAR 6 '57 DST 3764-73 30' 12'

Md BHP 240/20"

D&A