

Section 33 Township 21 Range 14 W

Well No. # 1 Cox (A) 'B'

Company Petroleum Inc.

NORTH

WEST	0							

EAST

SOUTH

Sec. 33 Twp. 21 R. 14W

Well No. #1 Cox (A) "B" Farm

Petroleum, Inc. Company


Garvey Oil Contractor

330' Lincoln
Ft. from N. Line

_____ Ft. from S. Line

_____ Ft. from E. Line

330' _____ Ft. from W. Line

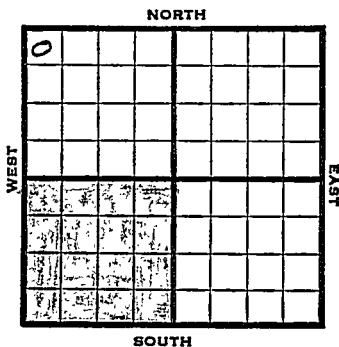

NW NW NW

1951

Elev. 1944' REPORT

12/19

Spud 12-17-51
8" @ 256
WOC

1952
1/2

Spud 12-17-51
D & A TD 3820' 8" @ 256'
Br. lime 3419' Lans. 3428'
DST 3543-58 open 90 min. rec 155' SW
DST 3560-99 open 1 hr. rec 63' SOCM
& water.
DST 3611-25 open 1/2 hr. rec 440' mud
& SW.
Cong. 3702' Sipp 3751' Arb. 3805'
TD 3820' D & A

ABANDONED

County Stafford State Kansas

Sec. 33 (Blk. 21 (Sur. Rge.) 14W Map No.

Operator Petroleum Inc.

Well No. I Farm Cox (A)

Elev. _____ Location NW NW NW

0					

330 Ft. From N Line NW

330 Ft. From W Line Quarter

1st. Report DEC 1 9 1951

Completion _____

Remarks MCPC near SW/22

Garvey - Contr.

Spudding Date 12-17-51

Drlg. Data Lincoln

8" @ 256 W.O.C.

J. E. TYRA

County Stafford State Kansas

Sec. 33 (^{Blk.}_{Twp.}) 21 (^{Sur.}_{Rge.}) 14W Map No.

Operator Petroleum Inc.

Well No. 1 Farm Cox "~~A~~" "B"

Elev. 1944 Location NW NW NW

0					

330 Ft. From N Line NW

330 Ft. From W Line Quarter

Ist. Report

Completion JAN 2 1952

Remarks Lincoln Pool

Garvey Oil - Contr.

Spudding Date 12-17-51

Drlg. Data D & A TD 3820

8" @ 256 Br. lime 3419 Lans. 3428

DST 3543-58 open 90 min. Rec. 155' sw

DST 3560-99 open 1 hr. Rec. 63' socm

& water DST 3611-25 open 1/2 hr. Rec.

440' mud & sw Cong. 3702 Simp. 3751

Arb. 3805 TD 3820

D & A

J. E. TYRA