


Stafford

DX 78-1

KANSAS

Section 33 Township 21 Range 11W
 Well No. #1 Strobel
 Company Hilton Drlg. NW SW SW

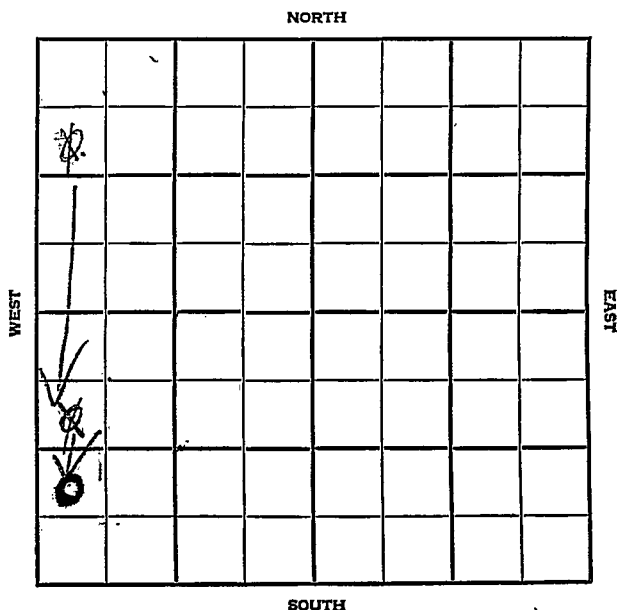

FR-12-5-56 shows #2 SWNW SW
 Comp 1-23-57 ✓
 Write Kansas office for
 info. 2-1-57

County Stafford Elev. _____
 Sec. 33 Twp. 21 Rgs. 11W
 Company Hilton Drlg.
 Farm Name Strobel No. 1

TOPS	DEPTH	LOG	DATUM	Loc. in Sec.
Anh.				SW NW NW
Tr.				NW SW SW
H.				
Tr.				
Dg.				
Bl.				
L.				Geol. _____
K.C.				Contr. _____
B.K.C.				Co. tools _____
Ce.				Pool <u>LINCOLN</u>
C.				Radium Twst. _____
M.				
M.				
K.				
Mz.				
Mo.				
V.				
S.				
S.				
A.				
R.				
Pe.				
G.				
T.D.				

Date Comm.

M I R

OCT 7 1966

CORRECTION

FORM 513 SUNRAY

County	Stafford	Elev.	1944
Sec.	33	Twp.	21
		Rge.	14W
Company	Hilton Drlg.		
Farm Name	Strobel		
		No.	1

TOPS	DEPTH	LOG	DATUM	Loc. in Sec.
Anb.	874			SW NW SE NW SW SW SW SW SW
Tp.				
H.	3317			
Tr.				
Dg.				
BL	3436			
EL	3445			
K.C.				Geol.
B.K.C.	3678			Contr.
Ce.				Co. tools
C.	3710			Pool New Pay
M.		LINCOLN POOL VI		Radium Twst.
M.				
K.				
Mz.				
Mo.				
V.	3749			X DEC 20 '58 COMPLETE
S.	3810			
S.				
A.	3862			
R.				
PE				
G.				
TD	3900			

Date Comm. **M I R** NOV 13 '56 **11-6-56 85/8 276**

1200 **3178** NOV 21 '56 **DST 3564**

-98 up 90" 64' OCWM FP

0-0 DHP 390/120" DST 3754

-65 up 90" 225/70" 3450'

clean oil FP 105-1190

DHP 1225/20 5 1/2 @ 3898/125

hu. 28 '56 **CO. 3870: 48/3760-66 +ST**

scum oil + 6 Gwph DEC 5 '58 500

CO 8/3760-66 11/4 FRAE
16# / 3754-60 16# / 3754-60
FU 3550' oil & 19 BOPH
NO/W 2000' O.B. T&R.
DEC 12 '58 P&P. DEC 19 '56
Ph P. 222 BOPD NO/W
graw 38°