

Pawnee


KANSAS

SECTION 33 TOWNSHIP 21 RANGE 16W

WELL NO. #1 Wile

COMPANY Rocket Drlg. Co.

NORTH

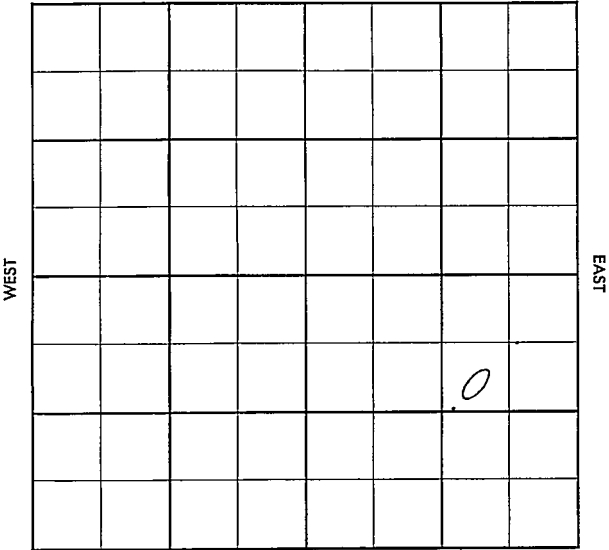

SOUTH

SEC. 33	TWP. 21	R. 16W
------------	------------	-----------

WELL NO. #1 Wile FARM

COMPANY Rocket Drlg Co

CONTRACTOR Co Tools Larned


_____ FT. FROM N. LINE

_____ FT. FROM S. LINE

_____ FT. FROM E. LINE

_____ FT. FROM W. LINE

SW NE SE

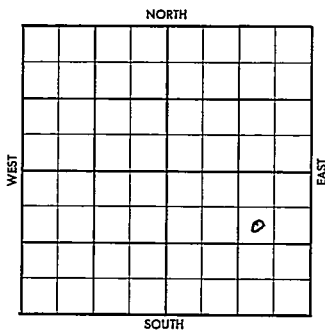

1956	ELEVATION	REPORT
------	-----------	--------

9-5 Loc

County Paynee Elev. _____
 Sec. 33 Twp. 21 Rge. 16W
 Company Rocket Drig. Co.
 Farm Name Wile No. 1

TOPS	DEPTH	LOG	DATUM
Anh.			
Tp.			
H.			
Tr.			
Dg.			
Bl.			
L.			
K.C.			
B.K.C.			
Ce.			
C.			
M.			
M.			
K.			
Mz.			
Ma.			
V.			
S.			
S.			
A.			
R.			
Pe.			
G.			
T.D.			

Loc. in Sec. _____
SW NE SE
 Geol. _____
 Contr. _____
 Co. Tools _____
 Pool _____
 Larned _____

FIRST REPORT	
SEP 5 '58	10

Date Comm. _____
 Location

Co. No. Sec. T. R.

County Parrylee Elev. 177
 Sec. 33 Twp. 21 Rge. 16W
 Company Rocket Drilg. Co.
 FarmName Wile No. 1

	TOPS	DEPTH	LOG	DATUM
Anh.		985		
TP				
H.		3051	3392	
Tr.				
Dg.				
Bl.		3493	3494	
L.		3502	3502	
K.C.				
B.K.C.				
Ce.				
C.				
M.				
M.				
K.				
Mz.				
Me.				
V.				
S.				
S.				
A.		3836	3836	
R.				
PE				
G.				
TD		3878		

Loc. in Sec. _____
 Geol. _____
 Contr. _____
 Co. Tools _____
 Pool _____
 Larned _____

LOANED
 OCT 24 '56

Date Comm.

Location SEP 12 '56 9-10-56

SEP 19 '56 85/8 991 1425 3740

SEP 26 '56 DST 3794-3843 1hr

6/2" see 450' oil + 360' VHT

0' E GCM + 460' G E SWCM 150-360

BHP 1000/20" DST 3843-48 1hr

6/7" see 180' VHT 0' GCM + 180'

SMO + 540' oil + Tr. wta + 180

oil & wta + 930' wta BHP 1000/20"

Co. No. Sec. T. R.

5 1/2 @ 3878/120 CO 36/3836-42

SSO 1/2 ^{OCT 3 '56} tst dry

PE 3827-30 18/3842-45

\$ 24 BO + 150 BW blue

hole in CS9 @ 1270 ^{OCT 10 '56} CO

3850 \$ 23 BO + 216 BW

7 hrs 599 211 MFS ^{OCT 17 '56} X CO

PE 40/3836-46 tst9 Log Tops

^{OCT 24 '56}

△ \$ 13 BO + 390

BW 9 hrs

DEA