

Pawnee


KANSAS

SECTION 33 TOWNSHIP 21 RANGE 16 TH

WELL NO. #1 Osbourn

COMPANY Recket Drilg.

NORTH

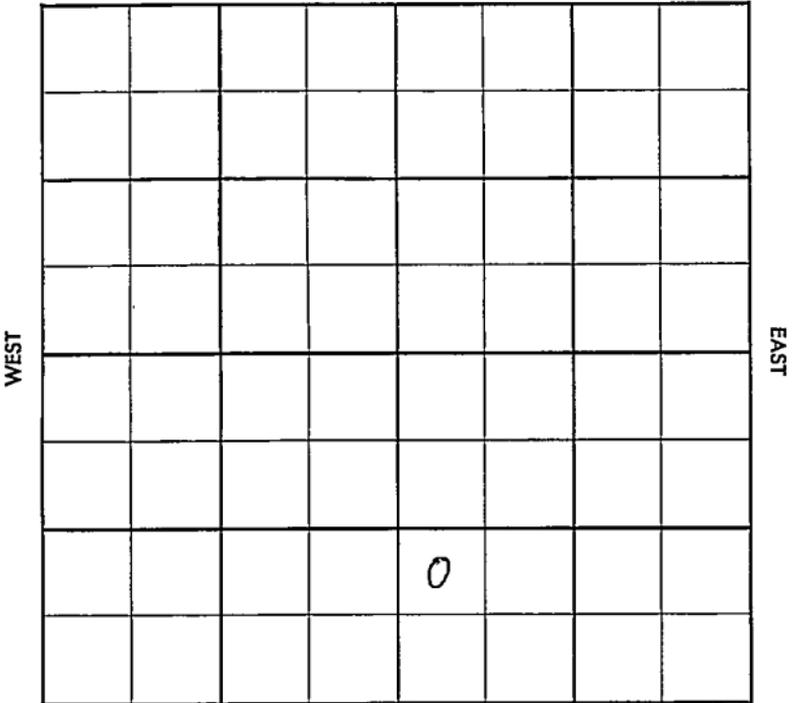

SOUTH

Pawnee


KANSAS

SEC. 33	TWP. 21	R. 16W
------------	------------	-----------

WELL NO. #1 Osbourn FARM  
 COMPANY

CONTRACTOR Rocket Drlg.  
 Co. tools

\_\_\_\_\_ Ft. from N. Line  
 \_\_\_\_\_ Ft. from S. Line  
 \_\_\_\_\_ Ft. from E. Line  
 \_\_\_\_\_ Ft. from W. Line

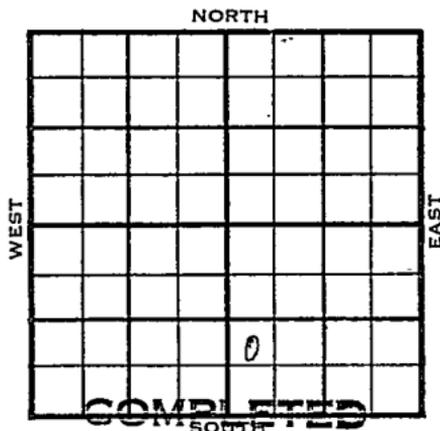

NW SW SE

1956	ELEVATION	REPORT
------	-----------	--------

1-25	MIR	
------	-----	--

County Pannee Elev. \_\_\_\_\_  
 Sec. 33 Twp. 21 Rge. 16W  
 Company Rocket Drlg.  
 FarmName Osbourn No. 1

TOPS	DEPTH	LOG	DATUM
Anh.			
TP.			
H.			
Tr.			
Dg.			
BL.			
L.			
K.C.			
B.K.C.			
Ce.			
C.			
M.			
M.			
K.			
Mz.			
Me.			
V.			
S.			
S.			
A.			
R.			
PE.			
G.			
T.D.			

Loc. in Sec. \_\_\_\_\_  
 NW SW SE  
 Geol. \_\_\_\_\_  
 Contr. \_\_\_\_\_  
 Co. tools \_\_\_\_\_  
 Pool \_\_\_\_\_

JAN 25 56  
 FIRST REPORT  
 P

Date Comm. M I R

*[Handwritten signature]*

Co.  
 Lse.  
 No.  
 Sec.  
 T.  
 R.

County **Pawnee** Elev. **1994**  
 Sec. **33** Twp. **(21)** Rge. **16W**  
 Company **Rocket Drig.**  
 Farm Name **Osbourn** No. **1**

TOPS	DEPTH	LOG	DATUM	Loc. in Sec.
Ank.				NW SW SE
Tr.				
H.	3395			
Tr.				
Dp.				
Rl.	3495		1501	
L.	3503		1509	Geol.
K.C.				Contr.
B.K.C.				Co. tools
Ce.				
C.				Pool
M.				
M.				
K.				
Mz.				
Mo.				
V.				
S.				
S.				
A	✓ 3841		1847	COMPLETE
R.				
PE.				
G.				
TD.	3842			

Date Comm. **MAR 7 1956**  
**MIR FEB 1 '56 1-26-56 85/8986**  
**1475 Ø 2950 FEB 8 '56 DST 3535**  
**-77 on 1hr see 185' WM BHP**  
**1020 ~~105~~ 5 1/2 @ 3841 1120 FEB 15 '56**  
**CO ~~300~~ DD 3846 300 acid**  
**& 3 1/2 Boph no/w 7 hrs FEB 22 '56**  
**• FEB - 27 '56 MAR 7 '56 PhFI 200 Bopd**  
**no/wtr ~~1000~~**  
**(Halt)**