


KANSAS

DX 78-1 Pawnee

Section 33 Township 21 Range 16W

Well No. #1 Palmer Unit

Company Rocket Drlg

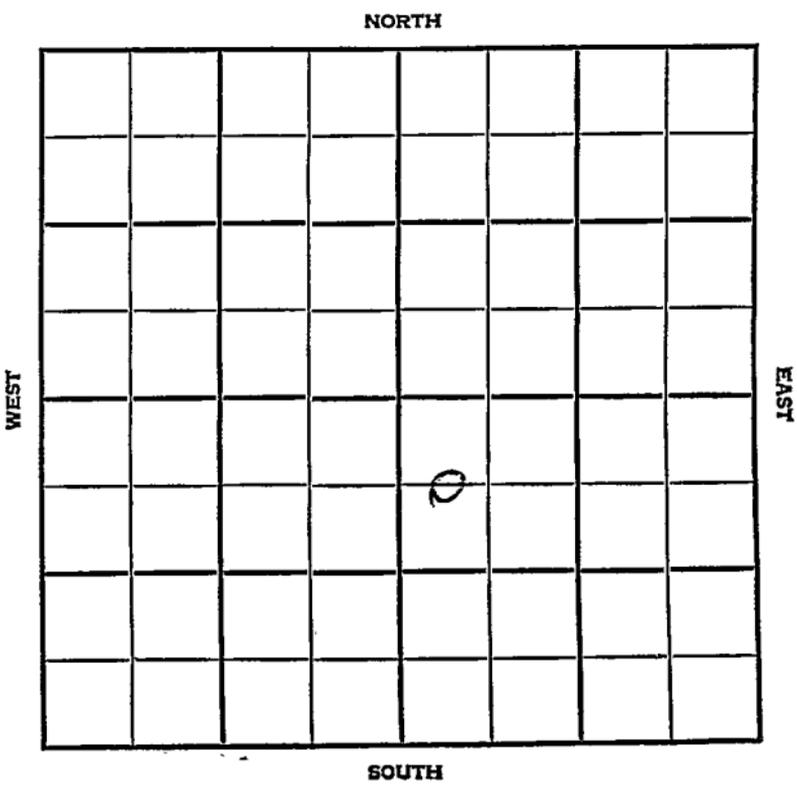

Pawnee

KANSAS

SEC.	TWP.	R.
33	21	16 W

WELL NO.

1 Palmer Unit

FARM

COMPANY

Rocket Drlg.

CONTRACTOR

Catools


Larned

_____ Ft. from N. Line

_____ Ft. from S. Line

_____ Ft. from E. Line

_____ Ft. from W. Line

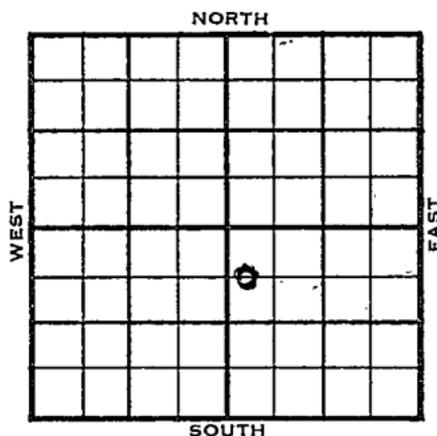C W $\frac{1}{2}$ NW SE

SDX - 1/4 Mile

	ELEVATION	REPORT
1956	1993'	

3/28 Location

4-5 Spud 3-29-56
8 5/8" @ 985
Drlg. 3200

4-12 Anhy 979
Heeb. 3398
Br. lime 3498
Lans. 3507
Arb. 3837
TD 3839
5 1/2" @ 3838 w/125

4-19 MICT
CO to 3839, 250 A
S & F/ 4 boph,
POP

4-26 F/ 82 bo, 17 hrs.

5-3 No report

5-10 No report

5-17 No report

5-23 Comp. P & F/ 84 bopd, 5% wtr.
TD 3839'

COMPLETED

County Paynee Elev. _____
 Sec. 33 Twp. 21N Rge. 16W
 Company Rocket Drlg.
 Farm Name Palmer Unit No. 1

TOPS	DEPTH	LOG	DATUM	Loc. in Sec.
Anh.				G W $\frac{1}{2}$ NW SE
TP.				
H.				
Tr.				
Dg.				
Bl.				
L.				Geol. _____
K.C.				Contr. _____
B.K.C.				Co. tools _____
Ce.				Pool _____
C.				Larned
M.				FIRST REPORT
M.				
K.				MAR 28 '56
Mz.				o
Me.				$\frac{1}{4}$ mile
V.				
S.				
S.				
A.				
R.				
PE.				
G.				
T.D.				

Date Comm. _____
 Location _____

Co.

Use.

No.

Sec.

T.

R.

County Pawnee Elev. 1993
 Sec. 33 Twp. 21 Rge. 16W
 Company Rocket Drlg.
 Farm Name Palmer Unit No. 1

TOPS	DEPTH	LOG	DATUM	Loc. in Sec.
Anh.	<u>979</u>			C W $\frac{1}{2}$ NW SE
Tr.				
H.	<u>3.398</u>			
Dg.				
BL.	<u>3498</u>		<u>1505</u>	
L.	<u>3507</u>		<u>1514</u>	Geol.
K.C.				Contr.
B.K.C.				Co. tools
Ce.				
C.				Pool
M.				Larned
Mz.				
Me.				
V.				
S.				
S.				
A.	<u>3837</u>		<u>1844</u>	COMPLETE
R.				
PE.				0
G.				
T.D.	<u>3839</u>			

Date Comm. 3-29-56

MAY 23 1956

8 5/8" @ 985/435 5 1/2" @ 3838/125CO to 3839 250 A S & F/ 4 bophF/ 82 b0 17 hr.Comp. P & F/ 84 bopd 5% wtr.