

Pawnee


KANSAS

SECTION 33 TOWNSHIP 21 RANGE 16W

WELL NO. #1 Palmer Unit

COMPANY Rocket Drlg.

NORTH

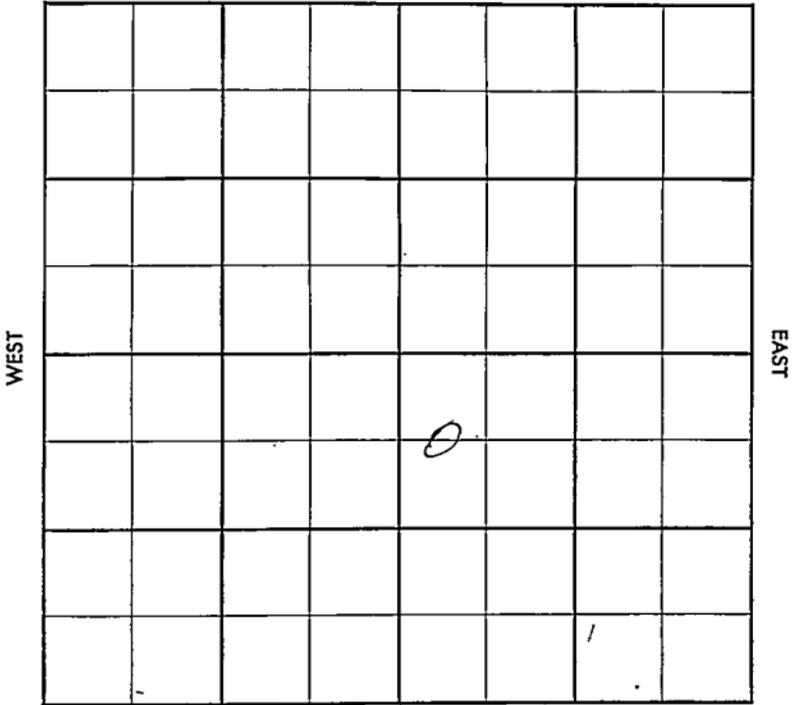

SOUTH

County Pawnee Elev. 1993  
 Sec. 33 Twp. 27 Rge. 16W  
 Company Rocket Drive  
 FarmName Palmer Unit No. 1

TOPS	DEPTH	LOG	DATUM	Loc. in Sec.
Anh.				<u>W 1/2 NW SE</u>
Tp.				<u>250' WL</u>
H.				
Tr.				
Dg.				
Bl.				
L.				
K.C.	<u>3507</u>			Geol. _____
B.K.C.				Contr. _____
Ce.				
C.				
M.				
M.				Pool
K.				<u>Larned</u>
Mz.				
Mq.				
V.				
S.				
S.				
A.	<u>3837</u>			
R.				
Pe.				
G.				
To.	<u>3839</u>			<b>COMPLETE</b> DEC 19 55 <b>FIRST REPORT</b>

Date Comm. 5" @ 3838 OTD 3839 DD 3842 750 MA  
S/ 10-15 bopd Comp. 15 bopd

~~N~~

Co.  
Lse.  
No.  
Sec.  
T.  
R.