


KANSAS Finney

FORM 51 5M PETROL

Section 33 Township 21 Range 34W

Well No. 1 Wright

Company Atlantic

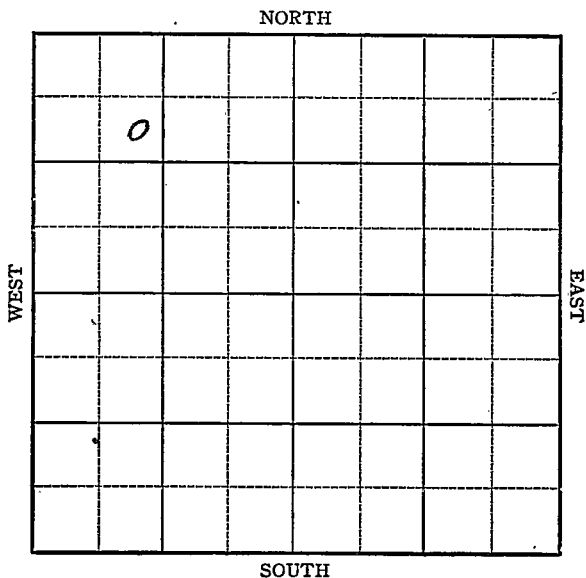

KANSAS

Finney

Sec. 33 Twp. 21 R. 34W

Well No. 1 Wright Farm

Atlantic Company

Wildcat

990

Ft. from N. Line

Ft. from S. Line

990


Ft. from E. Line

Ft. from W. Line

SE NW NW

Elev. 2978

NORTH

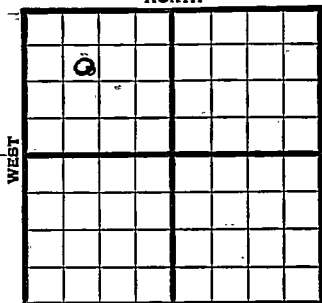

1945

REPORT

4/25

RUR

5/3

"

5/10

10" @ 275' WOC

5/17

Herrington 2505

Drlg. 2665

5/24

Herrington 2556 corrected

Krider 2605

Winefield 2669

Ft Riley 2730

3465' $\frac{1}{2}$ M Gas.

5/31

Lans 3832

Drlg. 4275'

6/6

Miss. 4582

TD 4629'

5" @ 4628' RUST

6/11

TD 4670

6/21

Miss 4711 corrected

144' of 4" liner @ 4689

Drlg. 4765 SSO

6/28

Drlg. 4872'

7/3

TD 4915

PB 4573-4557 s

Shot 4733-4743 2000 acid. & oil 3 gal
wtr. per hr.

7/11

PB 2688

Perf. 23 shots 2629-2632

Squeeze off. Perf.

7/19

112 shots 2598-2620 squeeze
WOC

OVER

1945

7/26 Plug 2590
94 shots 2537-2562
7000 acid.
5 M Gas.

8/8 Lans 3232
Miss. 4711
5" @ 4628'
T.^D. 4915'
Plug 2590
94 shots 2537-62
7000 acid
9,115,000 Gas
409# R Pr.

COMPLETED

Kansas Pool Name WildcatMap No. no map Sec. 33 Twp. 21 R. 34WWell No. 1 WrightAtlantic Company

FIRST REPORT

Contractor

SE NW NW

SECTION PLAT

6			

990 Ft. from N. Line Ft. from S. Line Ft. from E. Line990 Ft. from W. Line

Finney

Location Rig up

Drilling and Remarks:

RUR

RECORD

Cased in., ft.Sand Gas Oil Total Depth

PRODUCTION

1st 24 hrs. Nat. 1st 24 hrs. after shot Gas Cu. Ft.Dry Hole Abandoned

Date

APR 25 1945 19

S. J. LEWIS


Scout

KANSAS

Kansas

Pool Name WildcatMap No. no map Sec. 33 Twp. 21 R. 34WWell No. 1 WrightAtlantic CompanyCOMPLETED Contractor

SE NW NW

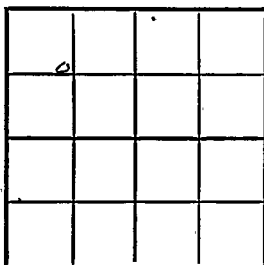E 12978
SECTION PLAT990 Ft. from N. Line Ft. from S. Line Ft. from E. Line990 Ft. from W. LineFinney CountyLocation Rig up

Drilling and Remarks:


Date

RECORD

Cased in., ft.Sand Gas Oil Total Depth 4915

PRODUCTION

1st 24 hrs. Nat. 1st 24 hrs. after shot Gas Cu. Ft.Dry Hole Abandoned

AUG 8 1945

19

S. J. LEWIS Scout