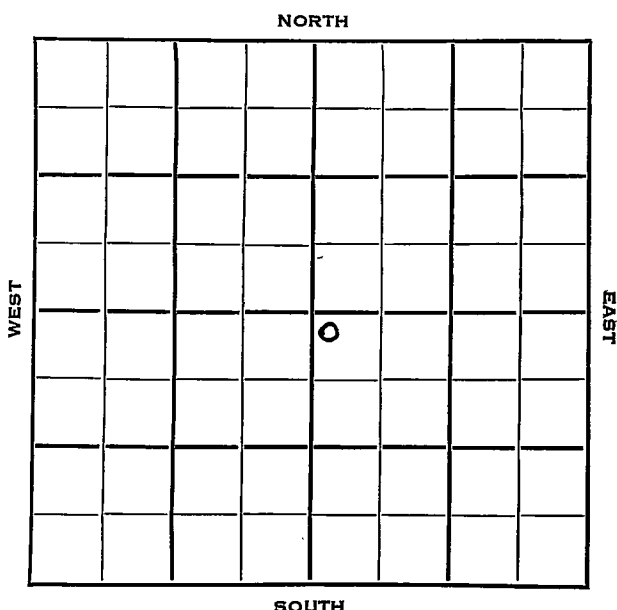


Section 33 Township 21 Range 35WWell No. 1 Claypool Gas UnitCompany Stanolind

Kearny KANSAS

SEC. 33	TWP. 21	R. 3 5W ✓
--	--	--

WELL NO. _____

1 Claypool Gas Unit FARM

COMPANY _____

Stanolind

CONTRACTOR _____


Hugoton Pool

150 _____ Ft. from N. Line

_____ Ft. from S. Line

_____ Ft. from E. Line

150 _____ Ft. from W. Line

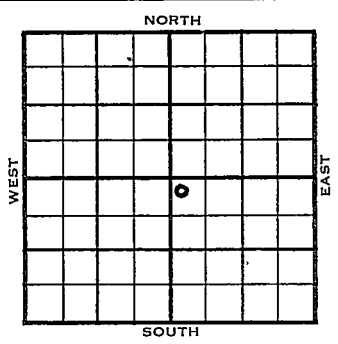

NW NW SE

	ELEVATION	REPORT
1954	3136'	
2/17	Location	
2/24	8" @ 840' w/500	
	Drlg. 2000'	
3/3	RTD 2764' Schl	
	5" @ 2743'	
	Her Kr 2625', Win 2683', Tow 2743'	
3/10	CO 2764 frac, 300 gswph	
	PB 2724, 24/2685-89, 24/2692-96,	
	36/2706-12, frac	
3/17	S/350 gswph	
	PB 2673	
	138/2630-53, 30/2656-61, NS	
	Frac.	
~~3/24~~	~~RTD 2764'~~	~~5" @ 2743'~~
~~3/24~~	~~NR~~	
3/24	NR	
4/7	NR	
4/14	Spud 2-18-54 - Gas Well	
	TD 2764'	
	8" @ 840	
	Her-Kri 2625', Win 2683', Tow 2743'	
	TD 2764	
	5" @ 2743	
	CO to 2764, dol-frac, 300 gswph	

(Information Brought Forward)

1954
4/14

PB 2724, 24/2685-89, 24/2692-96,
36/2706-12

Dol-frac, S/350 gswph

PB 2673

138/2630-53, 30/2656-61, frac.

Comp. 2,824,000 gas, 386#

COMPLETED

J. G. McGEHEE

County Kearny State Kansas

Sec. 33 (Blk. Twp.) 21 (Sur. Rge.) 35W Map No.

Operator Stanolind

Well No. 1 Farm Claypool Gas Unit

Elev.	3136	Location	NW NW SE
-------	------	----------	----------

[illegible]

150 Ft. From N Line SE c

150 Ft. From W Line Quarter

1st. Report

Completion **APR 14 1954**

Remarks Hugoton Pool

Spudding Date. 2-18-54

Drilg. Data Gas well TD 2764

8" @ 840 Her-Kri. 2625 Win. 2683

TOW. 2743 TD 2764 5" @ 2743 CO to 2764

dol-frac 300 gswph. PB 2724 24/ 2685-89

24/ 2692-96 36/ 2706-12 dol-frac

S/ 350 gswph, PB 2673 138/ 2630-53

30/ 2656-61 frac.

Comp. 2.824,000 gas 386#