



# AMERICAN ELEVATIONS, Inc.

WICHITA 316-262-3311

P.O. BOX 56

HAYS 913-625-4275

HAYS, KANSAS 67601



Lebsack Oil Production Inc.  
(OPERATOR)

1-18  
(NO)

L.R. Kester  
(LEASE)

Finney  
(COUNTY)

Ks.  
(STATE)

18 21s 34w  
S T R


1980'FS 1650'FW (+770'FEL of SW/4)  
(LOCATION)  
(irregular Sec.)

Rex  
(AUTHORIZED BY)

6-2-93  
(DATE)



Scale: 1" = 1000'

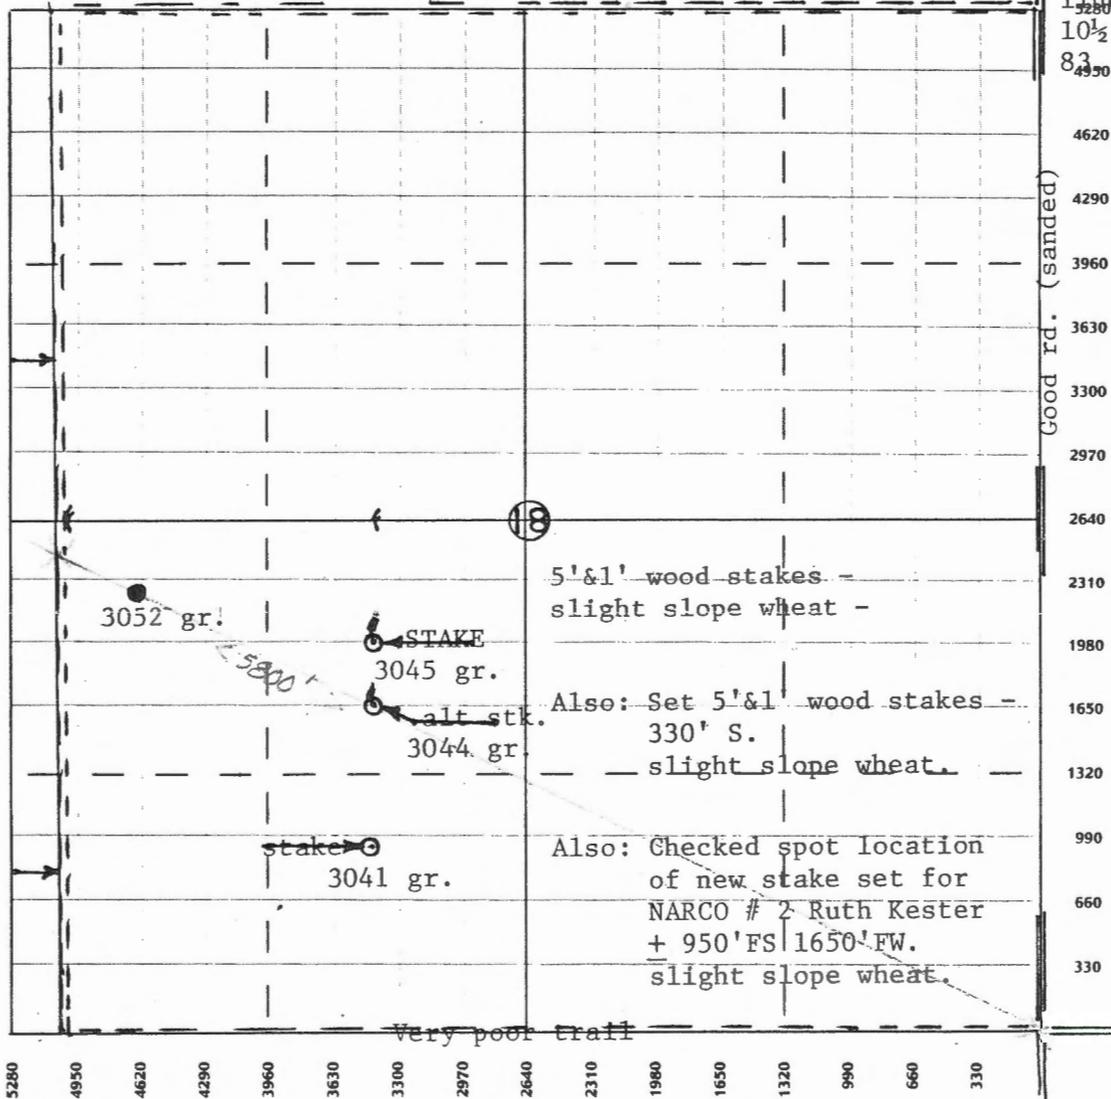

2 mi. N. to Co.  
line rd. then  
10 1/2 mi. E. to HWY  
83