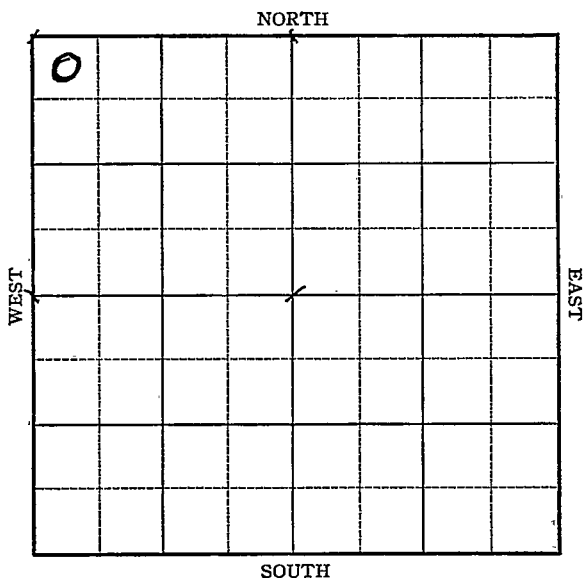



Stafford

KANSAS

Section 34 Township 21 Range 12-WWell No. 1 - K. KrentzelCompany Stanolind O&G

Sec. 34 Twp. 21 R. 12-WWell No. #1 K. Krentzel FarmStanolind O & G Company330 Ft. from N. Line Ft. from S. Line Ft. from E. Line330 Ft. from W. Line

Elev. 1854

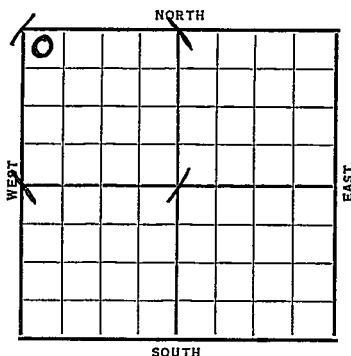

Date	REPORT
1937	
9/1	R U R
9/10	13" @ 247'. Drlg. 1417'.
9/17	Drl g. 2530'.
9/24	Drl g. 3333'.
10/2	K.C. 3276'. Sat. 3399-3405'.
	T.D. 3409'. 8" @ 3369'.
10/8	Swab 165 B.O. in 9 hrs.
10/15	Recementing pipe.
10/22	5" @ 3328'. 3000 acid.
	Flowed 139 B.O. 45 Min.
10/27	5" @ 3328'.
	K.C. 3276'.
	T.D. 3409'.
	3000 acid.
	Flow 448.87 bbls. 4 hrs & 304/5
	bbls. 4 hrs.
	Potential 1827 bbls.
	Gravity 34.9
	COMPLETED

Stafford KANSAS


Map No. 46 Sec. 34 Twp. 21 R. 12W

Well No. 1-K. Krentzel
Stanslind Oil Co. Company

Contractor

FIRST REPORT

SECTION PLAT

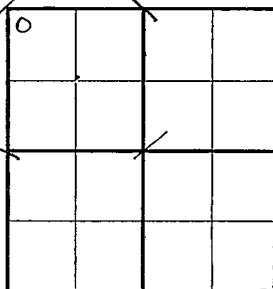

330 Ft. from N. Line

Ft. from S. Line

Ft. from E. Line

330 Ft. from W. Line

Location

Rig up

Drilling and Remarks:

PUR

RECORD

Cased in. ft.

Sand

Gas

Oil

Total Depth

PRODUCTION

1st 24 hrs. Nat.

1st 24 hrs. after shot

Gas Cu. Ft.

Dry Hole

Abandoned

Date

SEP 1 1937 19

H. D. Hatfield Scout

Stafford **KANSAS**Map No. _____ Sec. 34 Twp. 21 R. 12WWell No. 1 K. KrentzelStanolind

Company

Contractor

COMPLETED**NW/C**330 Ft. from N. Line

_____ Ft. from S. Line

_____ Ft. from E. Line

330 Ft. from W. Line**SECTION PLAT**

0			

Location _____

Rig up _____

Drilling and Remarks:

*3000 acid**Flow - 448.87/4**304.5/4**POT-1827**Grav. 34.9*

Date

RECORDCased 5 in., 3328 ft.Sand KC 3276

Gas _____

Oil _____

Total Depth 3409**PRODUCTION**

1st 24 hrs. Nat. _____

1st 24 hrs. after shot _____

Gas _____ Cu. Ft.

Dry Hole _____

Abandoned _____

OCT 27 1937 19H. D. Hatfield Scout