


Stafford

KANSAS

SECTION 34 TOWNSHIP 21 RANGE 12W

WELL NO. #4 Siefkes

COMPANY Tom Allen & CRA

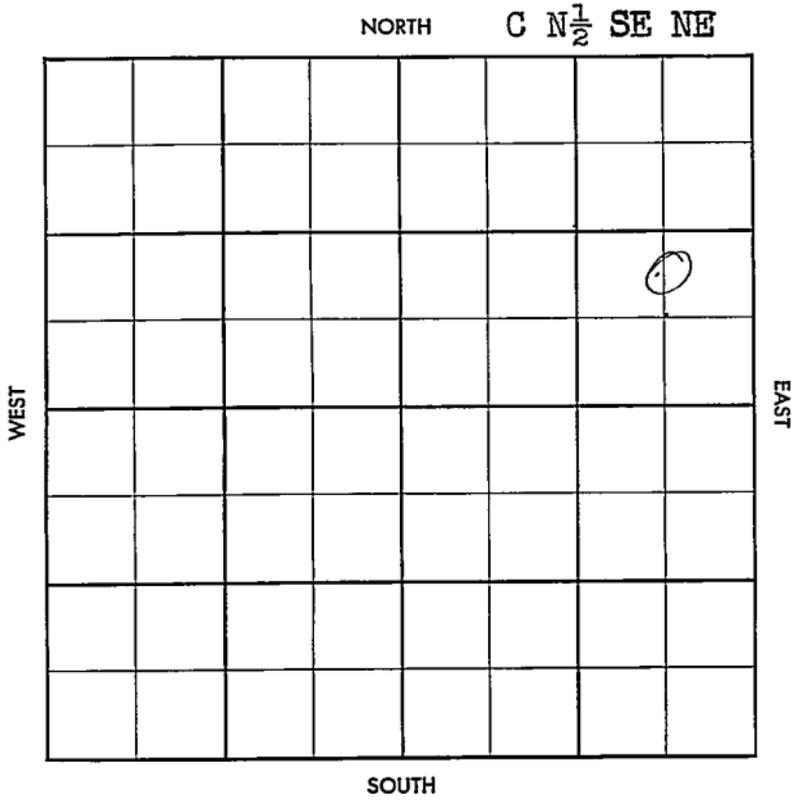

County Stafford Elev. _____
 Sec. 34 Twp. 21 Rgs. T2W
 Company Tom Allan & CRA
 Farm Name Siefkes No. 4

TOPS	DEPTH	LOG	DATUM
Anb.			
Tp.			
H.			
Tr.			
Dg.			
Bl.			
L.			
K.C.			
B.K.C.			
Ce.			
C.			
M.			
M.			
K.			
Mz.			
Ma.			
V.			
S.			
S.			
A.			
R.			
PE.			
G.			
T.D.			

Loc. in Sec. C N¹/₂ SE NE

Geol. _____
 Contr. Tom Allan

Pool Max

FIRST REPORT	

Date Comm. 1-20-57

Bit @ 245/200 drlg. 1450

~~13~~

Co.

Use.

No.

Sec.

T.

R.

County	Stafford	Elev.	1849
Sec.	31	Twp.	21
		Rgs.	12W
Company	Tom Allan & CRA		
Farm Name	Siefkes	No.	1

TOPS	DEPTH	LOG	DATUM	Loc. in Sec.
Anh.	634			C N $\frac{1}{2}$ SE NE
Ip.				
H.	3124			
Tr.				
Dg.				
Bl.	3256			
L.	3275			
K.C.				Geol.
B.K.C.				Contr.
Ce.				Tom Allan
C. - <u>soey</u>	3536			Pool
M.				Max
M.				
K.				
Mz.				
Mo.				
V.				
S.	3561			COMPLETE
S.				
A	3615			
R.				
PE.				
G.				
T.D.	3617			FEB 13 '57

Date Comm. 1-20-57

8" @ 245/200 drl. 1450 JAN 30 '57

D 3495 FEB 6 '57 5 1/2 @ 3617 DD

3630 S.O. 12 1/2 DD 3643 &

1 Boph no/w to DD FEB 13 '57

DD 3650 1 1/2 FU 400 oil \$

1 1/2 Boph no/w Pop. P.

est 25 Boph no/w tr