FORM 51


Stafford

KANSAS

Section 34 Township 21 Range 13W

Well No. #5 Gates

Company C. Hulm

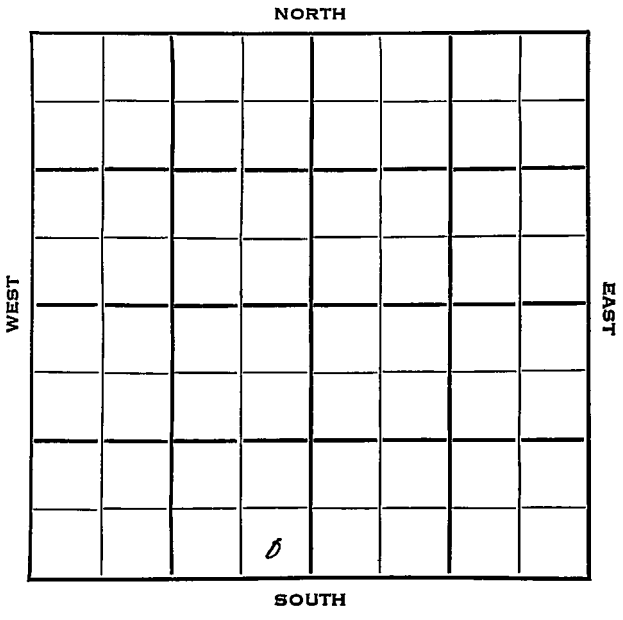

FORM 252-B

Stafford KANSAS

Sec. 34 Twp. 21 R. 13W ✓

Well No. #5 Gates Farm

C. Hulm Company

Hulm Contractor


____ Ft. from N. Line

330 Ft. from S. Line

330 Ft. from E. Line

____ Ft. from W. Line

SE SE SW

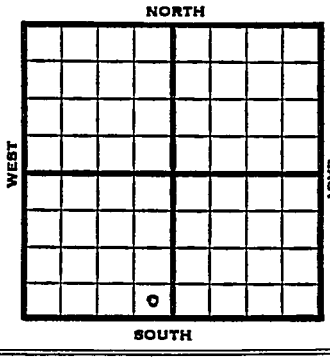

Elev. 1887' REPORT

1953

1/28 Spud 1-25-53
8" @ 265 Drlg.

2/5 Lans 3371
Drlg. 3420'

2/12 D&A

2/19 "

2/25 Spud 1-25-53
D&A
TD 3760
8" @ 265
Br lime 3364, Lans 3381, Viola 3651, Simp 3680
TD 3760
D&A

ABANDONED

FORM 275 FOR SALE BY KANSAS BLUE PRINT CO.


County Stafford State Kansas

Sec. 34 (Blk. Twp.) 21 (Sur. Rge.) 13W Map No.

Operator C. Hulm

Well No. 5 Farm Gates

Elev. Location SE SE SW

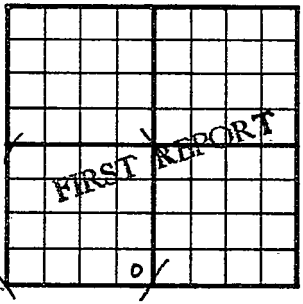

330 Ft. From S Line SW

330 Ft. From E Line Quarter

1st. Report JAN 2 8 1953

Completion

Remarks

Hulm - Contr.

Spudding Date 1-25-53

Drlg. Data

8" @ 265 drlg.

J. G. McGEHEE

FORM 275 FOR SALE BY KANSAS BLUE PRINT CO.


County Stafford State Kansas

Sec. 34 (Blk. Twp.) 21 (Sur. Rge.) 13W Map No.

Operator C. Hulm

Well No. 5 Farm Gates

Elev. 1887 Location SE SE SW

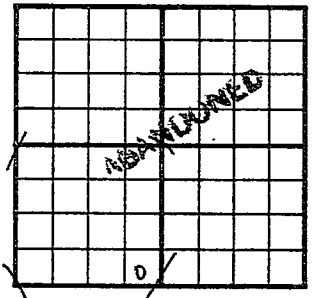

330 Ft. From S Line SW

330 Ft. From E Line Quarter

1st. Report

Completion FEB 25 1953

Remarks

Hulm - Contr.

Spudding Date 1-25-53

Drlg. Data D & A TD 3760

8" @ 265 Br. lime 3364 Lans. 3381

Viola 3651 Simp. 3680 TD 3760

D & A

J. G. McGEHEE