


Section 34 Township 21 Range 14W

Well No. #2 McGinty

Company Max Cohen

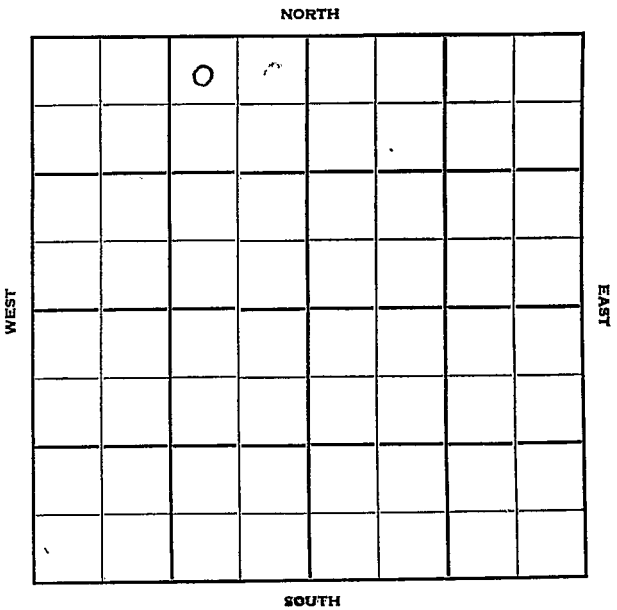

Stafford KANSAS

Sec. 34 Twp. 21 R. 14 W

Well No. #2 McGinty Farm

Max Cohen Company

Armer Contractor

Hickman Pool


330 Ft. from N. Line

_____ Ft. from S. Line

990 Ft. from E. Line

_____ Ft. from W. Line

NW NE NW

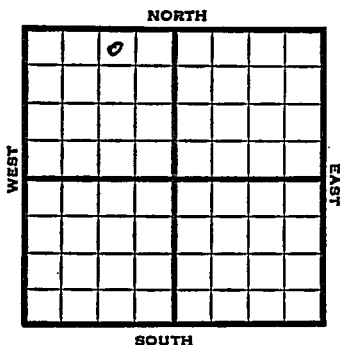

1951

Elev. 1943'

REPORT

2/7

Spud 2/3/51

8" @263'

Anhy 848

Drlg. 1525'

3/28

Spud 2-3-51

Oil Well TD 3786

8" @ 263

Anhy 848' Heeb. 3286

Br Lime 3404 Lans. 3415

DST 3532-48 opn 17 min

Rec. 335' oil Viola 3691

Simp 3728 Arb. 3781

TD 3786

5" @ 3783 24/3753-59 FU 950' oil

S/10-12 boph Comp. 305 bopd.

COMPLETED

County Stafford State Kansas

Sec. 34 (Blk. Twp.) 21 (Sur. Rge.) 14W Map No.

Operator Max Cohen

Well No. 2 Farm McGinty

Elev. _____ Location NW NE NW

		0					
FIRST REPORT							

330 Ft. From N Line NW

990 Ft. From E Line Quarter

1st. Report FEB 7 1951

Completion _____

Remarks _____

Armor - Contr.

Spudding Date 2-3-51

Drlg. Data Hickman Pool

8" @ 263 Anhy 848 drlg. 1525

County Stafford State Kansas

Sec. 34 (Blk. 21 (Sur. 14W (Twp. Rgs.) Map No.

Operator Max Cohen

Well No. 2 Farm McGinty

Elev. 1943 Location NW NE NW

		0					

330 Ft. From N Line NW

990 Ft. From E Line Quarter

1st. Report

Completion MAR 28 1951

Remarks Hickman Pool

Armer - Contr.

Spudding Date 2-3-51

Drlg. Data Oil well TD 3786

8" @ 263 Anhy 848 Heeb. 3286

Br. lime 3404 Lans. 3415 DST 3532-48

open 17 min. Rec. 335' oil Viola 3691

Simp. 3728 Arb. 3781 TD 3786

5" @ 3783 24/ 3753-59 FU 950' oil

S/ 10-12 boph Comp. 305 bopd

J. E. TYRA