


Stafford KANSAS

Section 34 Township 21 Range 14 W

Well No. # 3 Smith (A)

Company Petroleum Inc.

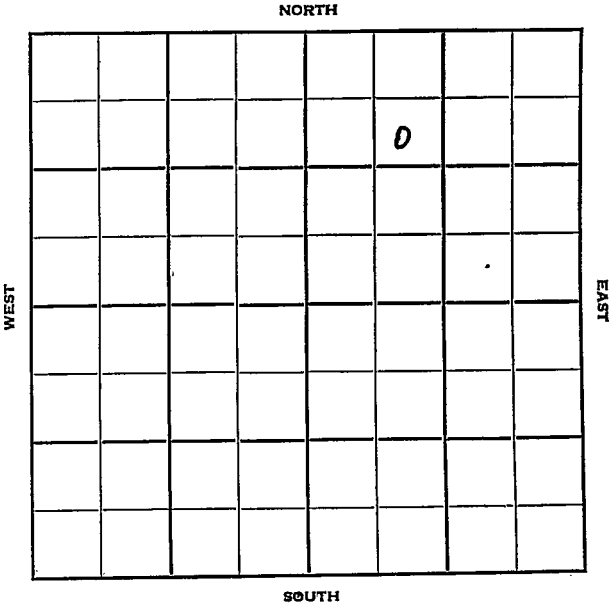

Sec. 34 Twp. 21 R. 14W

Well No. #3 Smith (A) Farm

Petroleum, Inc. Company

Garvie - Contr. Contractor


990' Ft. from N. Line

 Ft. from S. Line

 Ft. from E. Line

990' Ft. from W. Line

SE NW NE

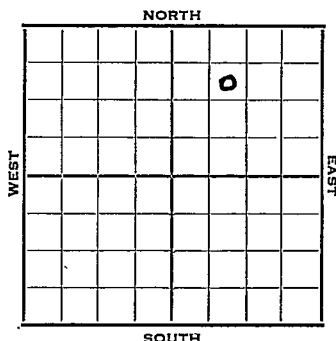

1952 Elev. 1938' REPORT

6/18 Spud 6-15-52
8" @ 251
Anhy 830
Drlg. 1200'

6/25 Heeb 3275 Br Li 3390
Lans. 3399
Brlg. 3473'

7/2 RTD 3780' 5" @ 3640 CO 3506'

7/9 60/3530-40 S/1/2 BOPH 2000 A
S/28 BOPH POP

7/17 NR

7/23 "

7/30 Spud 6-15-52
Oil Well TD 3780' 8" @ 251
Anhy 830 Heeb. 3275
Br Li 3390 Lans. 3399
DST 3533-45 open 1 hr. rec. 1065'
oil 270' frothy oil 750#
DST 3548-65 open 1 hr. rec. 62' ocm
450# DST 3569-85 open 1 hr. rec.
40' ocm 350# TD 3780 5" @ 3640
CO to 3506 60/ 3530-40 S/ 1/2 boph
2000 A S/ 28 boph Arb. 3777
Comp. 160 bopd

COMPLETED

County Stafford State Kansas
 Sec. 34 (Blk.) 21 (Sur.) 14W Map No.
 Operator Petroleum Inc.
 Well No. 3 Farm Smith (A)
 Elev. _____ Location SE NW NE

			0		


FIRST REPORT

990 Ft. From N Line NE
990 Ft. From W Line Quarter
 Ist. Report JUN 1 8 1952
 Completion _____
 Remarks _____
Garvie - Contr.
 Spudding Date 6-15-52

Drlg. Data

8" @ 251 Anhy 830 Drlg. 1200

J. G. McGEHEE

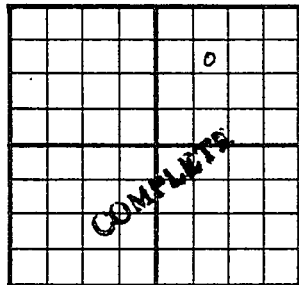County Stafford State KansasSec. 34 (Blk. Twp.) 21 (Sur. Rge.) 14W Map No. _____Operator Petroleum Inc.Well No. 3 Farm Smith "A"Elev. 1938 Location SE NW NE990 Ft. From N Line NE990 Ft. From W Line Quarter

1st. Report _____

Completion JUL 30 1952

Remarks _____

Garvey - Contr.Spudding Date 6-15-52Drilg. Data Oil well TD 37808" @ 251 Anhy 830 Heeb. 3275Br. lime 3390 Lans. 3399 DST 3533-45open 1 hr. Rec. 1065' oil 270' frothyoil 750# DST 3548-65 open 1 hr.Rec. 62' ocm 450#' DST 3569-85open 1 hr. Rec. 40' ocm 350# TD 37805" @ 3640 CO to 3506 60/ 3530-40S/ $\frac{1}{2}$ boph. 2000 A S/ 28 boph Arb. 3777Comp. 160 bopd