


Section 25-34 Township 21 Range 16W

Well No. #2 Dipman

Company Musgrove Pet.

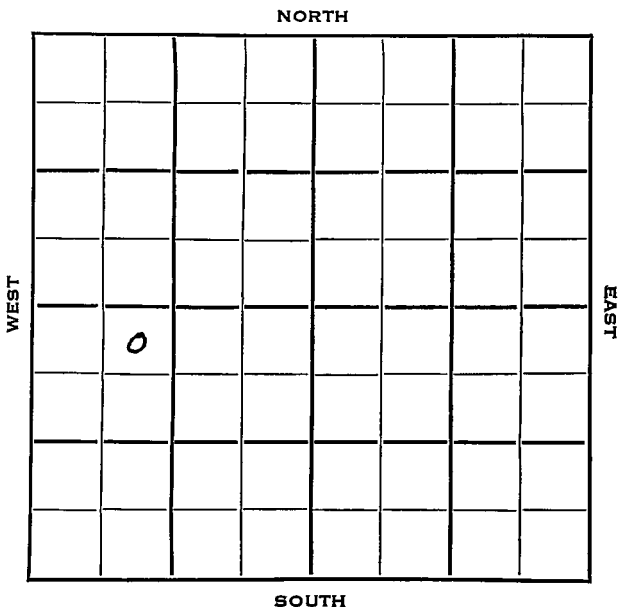



Sec. 23-34 Twp. 21 R. 16W

Well No. #2 Dipman Farm

Musgrove Petr. Company

Musgrove Contractor

Larned Pool


330 Ft. from N. Line

\_\_\_\_\_ Ft. from S. Line

\_\_\_\_\_ Ft. from E. Line

990 Ft. from W. Line

NE NW SW

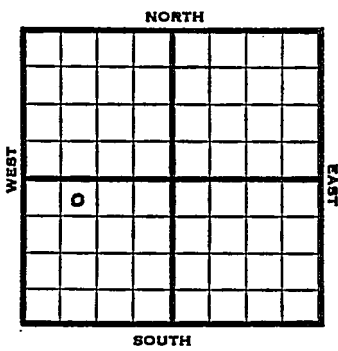

1953

Elev. 1987' REPORT

4/22 Spud 4-16-53  
8" @ 988  
Drlg. 2270'

4/30 Anhy 984  
Drlg.

5/7 Heeb 3411, Br li 3516, Lans 3526,  
Cong 3975, Arb 4041  
RTD 4143  
5" @ 4090  
D&A  
To Be SWD

*4041  
3526  
-----  
5131*

5/21 DD 4189

5/28 TD 4191'

*4041  
1987  
-----  
2054*

6/3 NR

6/10 NR

6/17 Spud 4-16-53 SWD well TD 4191  
8" @ 988 Anhy 984 Heeb 3411  
Br line 3516 Lans 3526 Cong 3975  
Arb. 4041 TD 4143 5" @ 4091  
CO to 4143 S/20 BWPH DD 4152  
DD 4189 DD 4191  
Comp. for SWD well

**ABANDONED**

County Pawnee State Kansas

Sec. 23 (Blk. Twp.) 21 (Sur. Rge.) 16W Map No.

Operator Musgrove Pet.

Well No. 2 Farm Dipman

Elev. \_\_\_\_\_ Location NE NW SW


330 Ft. From N Line SW

990 Ft. From W Line Quarter

Ist. Report APR 22 1953

Completion \_\_\_\_\_

Remarks \_\_\_\_\_

Musgrove - Contr.

Spudding Date 4-16-53

Drlg. Data Larned Pool

8" @ 988 drlg. 2270

Map No. \_\_\_\_\_ Sec. 34 Twp. 21 R. 16W

Well No. 2 Dipman

Musgrove Pet. Company

**CORRECTION**

Contractor

NE NW SW

SECTION PLAT

330 Ft. from N. Line

\_\_\_\_\_ Ft. from S. Line

\_\_\_\_\_ Ft. from E. Line

990 Ft. from W. Line

p			

Pawnee County

Location \_\_\_\_\_

Rig up \_\_\_\_\_

Drilling and Remarks:

Reported  
23-21-16W

RECORD

Cased \_\_\_\_\_ in., \_\_\_\_\_ ft.

Sand \_\_\_\_\_

Gas \_\_\_\_\_

Oil \_\_\_\_\_

Total Depth \_\_\_\_\_

PRODUCTION

1st 24 hrs. Nat. \_\_\_\_\_

1st 24 hrs. after shot \_\_\_\_\_

Gas \_\_\_\_\_ Cu. Ft.

Dry Hole \_\_\_\_\_

Abandoned \_\_\_\_\_

Date

APR 22 1953

19

J. G. McGEHEE

Scout

County Pawnee State Kansas

Sec. 34 (Blk. Twp.) 21 (Sur. Rge.) 16W Map No.

Operator Musgrove Pet.

Well No. 2 Farm Dipman

Elev. 1987 Location NE NW SW


330 Ft. From N Line SW

990 Ft. From W Line Quarter

1st. Report

Completion JUN 17 1953

Remarks Larned Pool

Musgrove - Contr.

Spudding Date 4-16-53

Drilg. Data SWD well TD 4191

8" @ 988 Anhy 984 Heeb. 3411

Br. lime 3516 Lans. 3526 Cong. 3975

Arb. 4041 TD 4143 5" @ 4091 CO to 4143

S/ 20 bwph DD 4152 DD 4189 DD 4191

Comp. for SWD well