


Section 34 Township 21 Range 16W

Well No. #2 Fairbanks

Company Musgrove Pet.

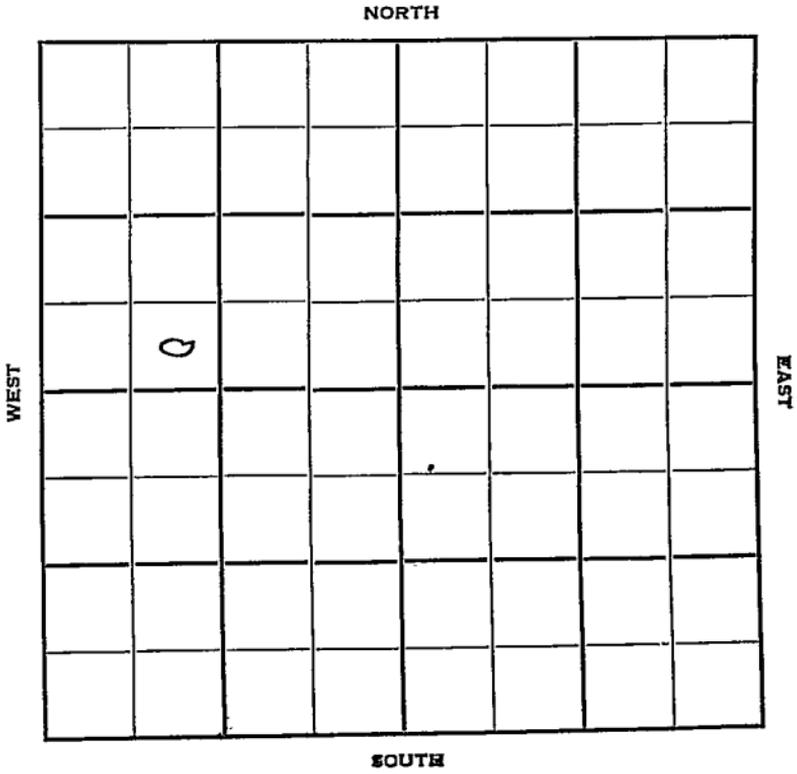

Sec. 34 Twp. 21 R. 16W

Well No. #2 Fairbanks Farm

Musgrove Petr. Company

Contractor

Ft. from N. Line


330 Ft. from S. Line

Ft. from E. Line

990 Ft. from W. Line

NW $\frac{1}{4}$  SE SW NW

MCPG has N $\frac{1}{2}$  SW/27

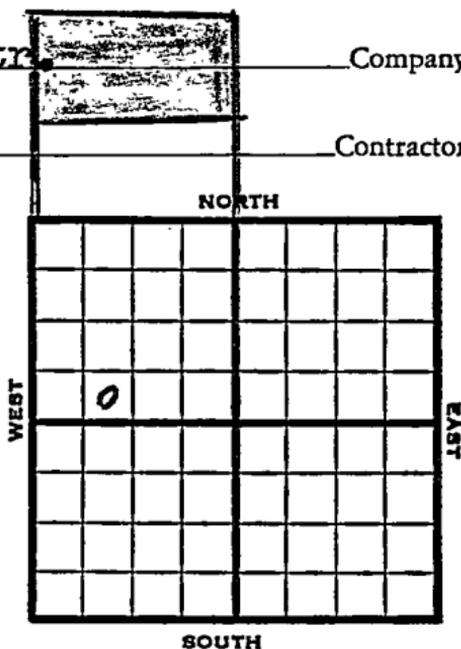

1952

Elev. 1988'

REPORT

11/12 Location

11/20 8" @ 943  
Drlg. 2900'

11/27 Heeb 3403, Br li 3505, Lans 3513

DST 3532-54, 1 hr., 15' M  
Arb 3865-68 RTD

5" @ 3866'

12/4 NR

12/18 500A No Help POP

12/30 Spud 11-11-52 Oil well TD 3871'  
8" @ 943 Heeb 3403' Br. line 3505'  
Lans. 3513'

DST 3532-54 open 1 hr. rec 15' mud  
Arb. 3865' TD 3868' 5" @ 3866'

DD 3871' S/6 BOPH S/823 BOPD  
500 A Comp. 917 BOPD

**COMPLETED**

*3865  
3513  
3505*

*3865  
1988  
1877*



