


Section 34 Township 21 Range 16 W

Well No. # 3 Peterson

Company Gulf Oil

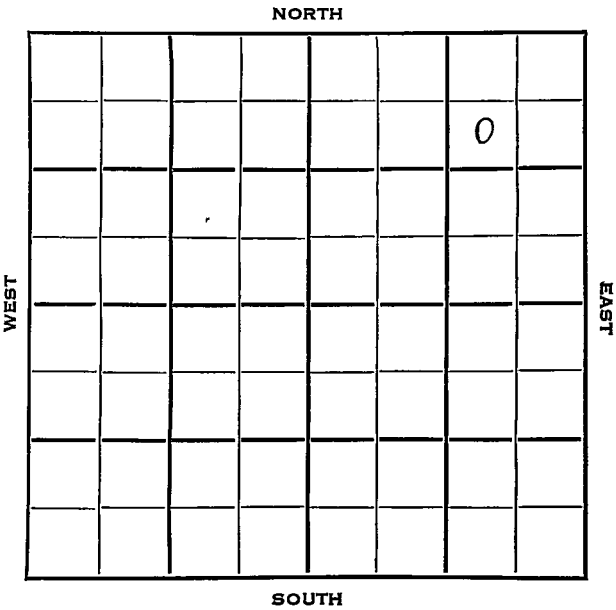

Pawnee KANSAS

SEC.	TWP.	R.
34	21	16W ✓
WELL NO.		
3 Peterson		FARM
COMPANY		
Garvey GULF OIL		
CONTRACTOR		


Larned Pool

990 Ft. from N. Line

Ft. from S. Line

990 Ft. from E. Line

Ft. from W. Line

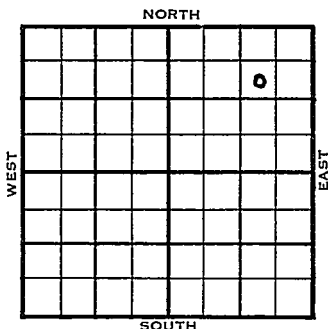

SW NE NE

1953	ELEVATION 1983'	REPORT
12/16	Spud 12-11-53 10" @ 975'	
1954 1/27	Spud 12-11-53 Oil Well TD 3860' 10" @ 975' Heeb 3377', Br. Lime 3476', Lans 3487' DST 3490'-3533' opn 1 hr, rec 20' Mud 70# Simp 3797' Arb 3855' DST 3856'-60' opn 1 hr, rec 1800' gas, 420' oil, 240' ocm 1190# TD 3860' 7" @ 3856' CO to 3860' S/ 35½ boph 300 A S/ 39 boph Comp 356 bopd.	
		COMPLETED

County **Pawnee** State **Kansas**

Sec. **34** (Blk. **21** (Sur. **16W** Map No.

Operator **Gulf Oil**

Well No. **3** Farm **Peterson**

Elev.	Location	SW	NE	NE
-------	----------	----	----	----

FIRST REPORT

990 Ft. From N Line NE

990 Ft. From E Line Quarter

1st. Report DEC 16 1953

Completion

Remarks


Garvey - Contr.

Spudding Date **12-11-53**

Drig. Data	Larned Pool

10" @ 975

J. G. McGEHEE

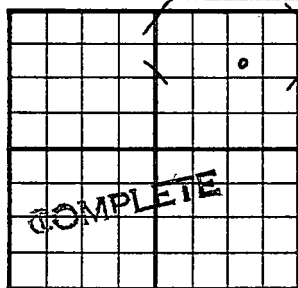County Pawnee State KansasSec. 34 (Blk. Twp.) 21 (Sur. Rge.) 16W Map No.Operator Gulf OilWell No. 3 Farm PetersonElev. 1983 Location SW NE NE990 Ft. From N Line NE990 Ft. From E Line Quarter

1st. Report

Completion JAN 27 1954Remarks Larned PoolGarvey - Contr.Spudding Date 12-11-53Drlg. Data Oil well TD 386010" @ 975 Heeb. 3377 Br. lime 3476Lans. 3487 DST 3490-3533 open 1 hr.Rec. 20' mud 70# Simp. 3797Arb. 3855 DST 3856-60 open 1 hr.Rec. 1800' gas 420' oil 240' ocm1190# TD 3860 7" @ 3856 CO to 3860S/ 35½ boph 300 A S/ 39 bophComp. 356 bopd

J. G. McGEHEE