


Section 34 Township 21 Range 16W

Well No. 2 M. A. Musselman

Company Gulf Oil Company

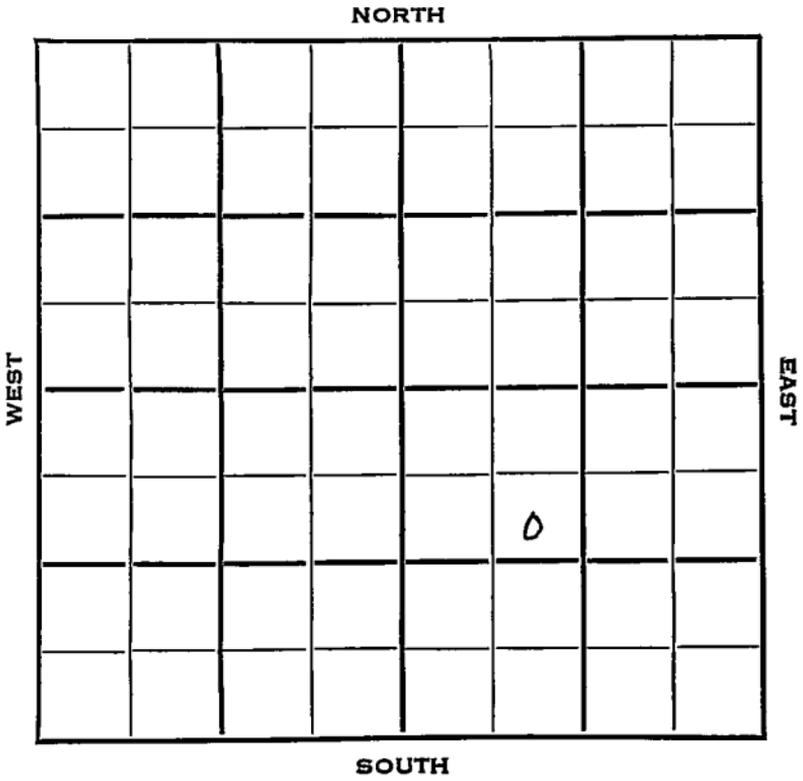

Pawnee

KANSAS ✓

Sec. 34 Twp. 21 R. 16W

Well No. #2 M. A. Musselman Farm

Gulf Oil Company

Barbour Drlg. Contractor

Larned Pool


990 Ft. from N. Line

Ft. from S. Line

Ft. from E. Line

990 Ft. from W. Line

SE NW SE

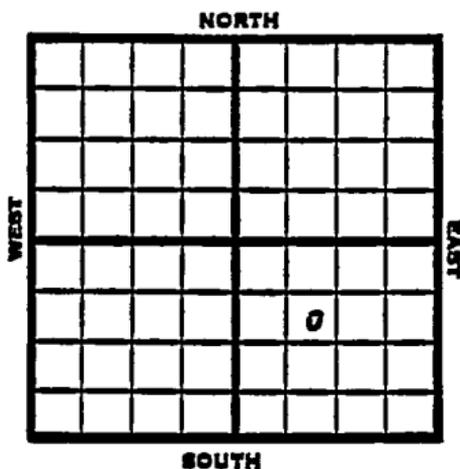

1952 Elev. 1988' REPORT

12/17 MIR

12/25 MIR

1953

1/7

Spud 12-19-52

D&A

TD 4009

Anhy 979

8" @ 983

Heeb 3411, Tor 3447, Br lime

3511, Lans 3519, Viola 3826,

Simp. 3861, Arb. 3918

DST 3920-64, opn 1/2 hrs., rec.

15' mud, 15#

DST 3964-4009 opn 1 hr., rec.

1100' SW, 1300# TD 4009

D&A

$$\begin{array}{r} 3918 \\ 1930 \\ \hline 1988 \end{array}$$

ABANDONED

$$\begin{array}{r} 3918 \\ 3519 \\ \hline 399 \end{array}$$

County Pawnee State Kansas

Sec. 34 (Blk. Twp.) 21 (Sur. Rge.) 16W Map No.

Operator Gulf Oil

Well No. 2 Farm M. A. Musselman

Elev. 1988 Location SE NW SE

ABANDONED

990 Ft. From N Line SE

990 Ft. From W Line Quarter

1st. Report

Completion JAN 7 1953

Remarks Larned Pool

Barbour Drlg. - Contr.

Spudding Date 12-19-52

Drlg. Data D & A TD 4009

Anhy 979 8" @ 983 Heeb. 3411

Tor. 3447 Br. lime 3511 Lans. 3519

Viola 3826 Simp. 3861 Arb. 3918

DST 3920-64 open $\frac{1}{2}$ hr. Rec. 15' mud

15# DST 3964-4009 open 1 hr. Rec.

1100' sw 1300# TD 4009

D & A