


Section 34 Township 21 Range 16W

Well No. #2 Phimey

Company Musgrove Pet.

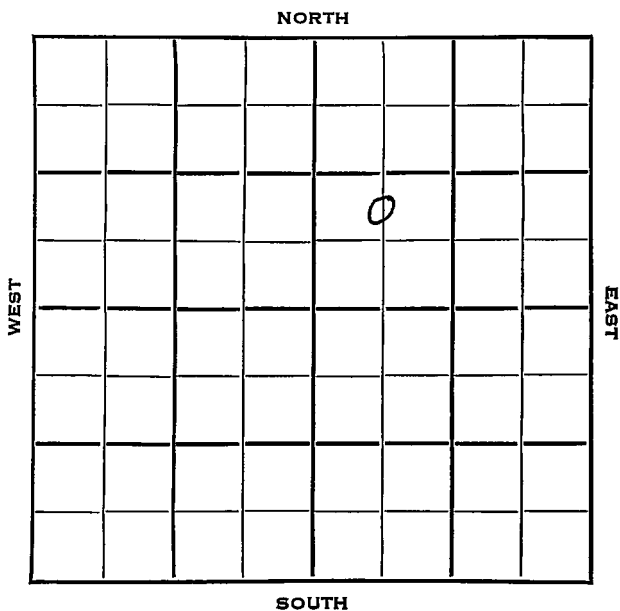

Sec. 34 Twp. 21 R. 16W

Well No. #2 Phinney Farm

Musgorve Petr. Company

Musgorve Contractor


Ft. from N. Line

990 Ft. from S. Line

Ft. from E. Line

660 Ft. from W. Line

C N L SW NE

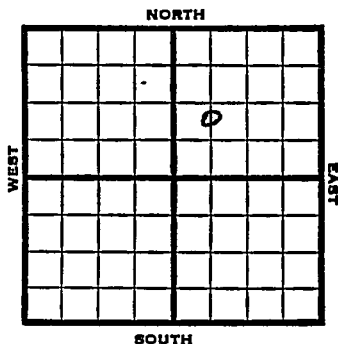

1953 Elev. 1981' REPORT

8/12 Spud 8-7-53
8" @ 975
Drlg. 2070'

8/19 Drlg. 3696'

8/26 Heeb 3380, Tor 3399, Br. li 3478,
Lans 3487, Simp ~~3~~ 3783, Arb 3850
RTD 3853
5" @ 3851'

9/2 N.R.

9/9 CO 3853
FU 1000' oil $\frac{1}{2}$ hr, DD 3854 $\frac{1}{2}$
S/ 5 $\frac{1}{2}$ boph D.D.

9/16 DD 3850 $\frac{1}{2}$ TD, POP

9/23 Spud 8-7-53
Oil Well
TD 3858'
8" @ 975'
Heeb. 3380, Tor 3399, Br. Lime 3478,
Lans 3487, Simp 3783, Arb 3850
TD 3853'
5" @ 3851'
GO to 3853 FU 1000' oil p hr.
DD 3854'

10
5 1
4 2 1
3 2 9 3
3 5 4 3

10
3 8 2 1
1 9 2 1
1 8 6 9

OVER

1953

Information brought forward.

9/23 S/ $5\frac{1}{2}$ boph DD 3858
Comp. 3000 bopd.

COMPLETED

