


Section 34 Township 21 Range 16W

Well No. #1 Phinney

Company Musgrove Pet.

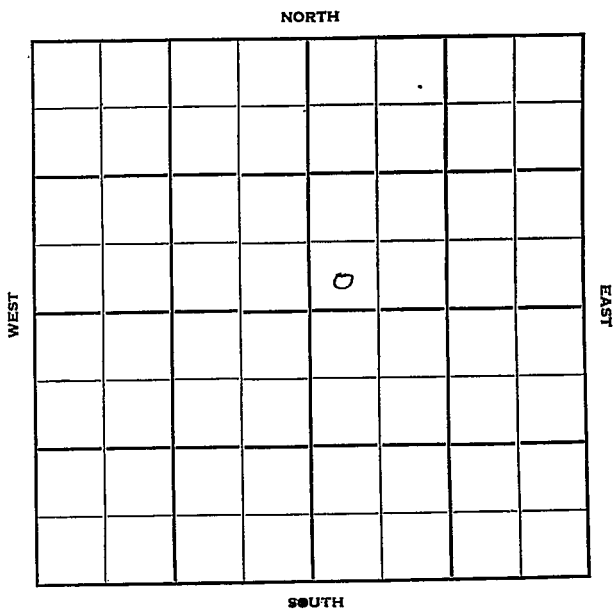

Sec. 34 Twp. 21 R. 16 W

Well No. # 1 Phinney Farm

Musgrove Pet. Company


Musgrove Contractor  
Wildcat

         Ft. from N. Line

330 Ft. from S. Line

         Ft. from E. Line

330 Ft. from W. Line

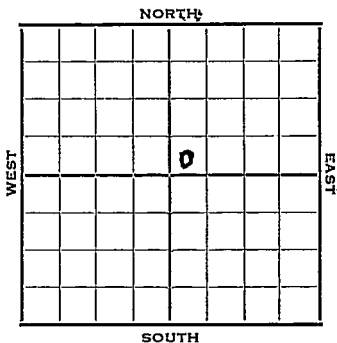

SW SW NE

Gulf & Sunray support

1952 Elev. 1983' REPORT

7/23	MIR	
7/30	8" @ 948' Drlg.	
8/6	Anhy 1740 Heeb. 3381	$\begin{array}{r} 240 \\ 306 \\ 13/3 \\ \hline 360 \end{array}$
	Br Li 3480 Lans 3489	
	Drlg. 3563	
8/13	Cong. 3792 Arb. 3849	$\begin{array}{r} 3849 \\ 1983 \\ \hline 862 \end{array}$
	DST 3851-56, 1 hr. 3360' oil	
	FP 520 to 1180 1270# RTD 3854	
	5" @ 3848'	
8/20	CO 3856 Fill up 3386 oil S/7½ BOPH	
	3086' off Btm S/15 BOPH POP	
8/27	NR	
9/3	"	
9/10	Spud 7-27-52	
	Oil Well TD 3854 8" @ 948	
	Anhy 1740 Heeb. 3381	
	Br Li 3480 Lans. 3489	
	Cong. 3792 Arb. 3849	
	DST 3851-56 open 1 hr. rec. 3360'	
	oil 1270# TD 3854 5" @ 3848	
	CO to 3856 FU 3386' oil S/ 7½ boph	
	S/ 2000 bopd	
	Comp. BHB 3000 bopd	

**COMPLETED**


County **Pawnee** State **Kansas**

Sec. **34** (Blk. Twp.) **21** (Sur. Rge.) **16W** Map No.

Operator **Musgrove Pet.**

Well No. **1** Farm **Phinney**

Elev. \_\_\_\_\_ Location **SW SW NE**

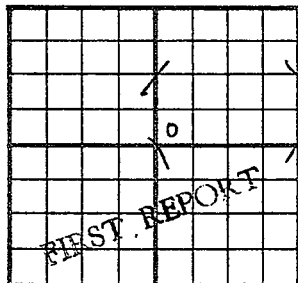

**330** Ft. From **S** Line **NE**

**330** Ft. From **W** Line Quarter

1st. Report **JUL 23 1952**

Completion \_\_\_\_\_

Remarks **Gulf & Sunray support**

**Musgrove - Contr.**

Spudding Date \_\_\_\_\_

Drlg. Data **Wildcat**

**M I R**


County Pawnee State Kansas

Sec. 34 (Blk. Twp.) 21 (Sur. Rge.) 16W Map No.

Operator Musgrove Pet.

Well No. 1 Farm Phinney

Elev. 1983 Location SW SW NE

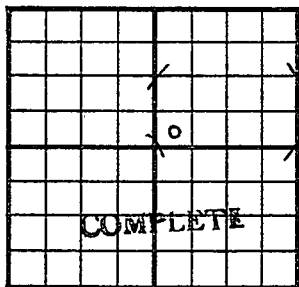

330 Ft. From S Line NE

330 Ft. From W Line Quarter

1st. Report

Completion SEP 10 1952

Remarks Wildcat

Musgrove - Contr.

Spudding Date 7-27-52

Drlg. Data Oil well TD 3854

8" @ 948 Anhy 1740 Heeb. 3381

Br. lime 3480 Lans. 3489 Cong. 3792

Arb. 3849 DST 3851-56 open 1 hr.

Rec. 3360' oil 1270# TD 3854

5" @ 3848 CO to 3856 FT 3386' oil

S/ 7½ boph S/ 15 boph S/ 2000 bopd

Comp. BHB 3000 bopd

J. G. MCGEHEE