

Pawnee

Section 34 Township 21 **KANSAS** Range 16W
Well No. #1 Peterson
Company Gulf Oil Company

				0			

NORTH

WEST

EAST

SOUTH

HOT FILE

Pawnee

KANSAS

Sec. 34 Twp. 21 R. 16 W

Well No. # 1 Peterson Farm

Gulf Oil

Company

Barbour

Contractor

Larned Pool

330 Ft. from N. Line


 Ft. from S. Line

 Ft. from E. Line

330 Ft. from W. Line

NW NW NE

MCPC has $N\frac{1}{2}$ SW of 27

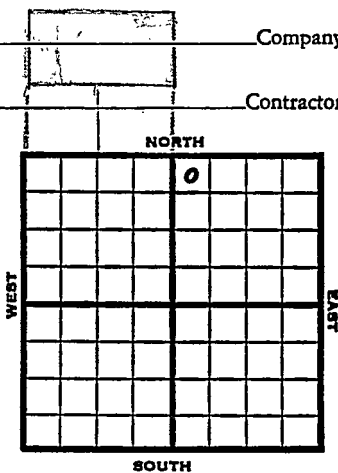

1953

Elev. 1991' REPORT

3/25

Spud 3-20-53

Drlg. 1965'

4/2

Heeb 3386, Tor 3401, Br Li 3486,
Lans 3496, Cong 3788, Simp 3806,
Arb 3855
RTD 3859
5" @ 3857

*3855
3496
3401
359*

4/10

CO to 3859' S/102 BO 4 hr. 1500' off
bottom. DD 3861' S/41 BOPH 2 hr.
1040' off bottom. Putting on pump. (Ltr)

4/17

No report

(Ltr)

4/23

"

4/29

Spud 3-20-53

Oil Well

TD 3861'

8" @ 977'

Heeb 3386, Tor 3401, Br. Lime 3486,
Lans 3496, Cong 3788, Simp 3806, Arb
3855

TD 3859

5" @ 3857'

CO to 3859 S/ 102 bo 4 hr. DD 3861
S/ 41 boph 2 hr.

Comp. 3000 bopd.

*3855
1991
864*

COMPLETED


County Pawnee State KansasSec. 34 (Blk.) 21 (Sur.) 16W Map No.Operator Gulf OilWell No. 1 Farm PetersonElev. Location NNNW NE

FIRST REPORT

330 Ft. From N Line NE330 Ft. From W Line Quarter1st. Report MAR 25 1953

Completion.

Remarks MCPC has N¹/₂SW of 27Barbour - Contr.Spudding Date 3-20-53Drlg. Data Larned Pooldrlg. 1965

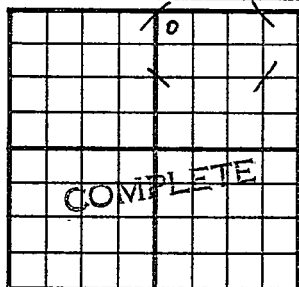County Pawnee State KansasSec. 34 (Blk. Twp.) 21 (Sur. Rge.) 16W Map No.Operator Gulf OilWell No. 1 Farm PetersonElev. 1991 Location NW NW NE330 Ft. From N Line NE330 Ft. From W Line Quarter1st. ReportCompletion APR 29 1953Remarks Larned PoolBarbour - Contr.Spudding Date 3-20-53Drlg. Data Oil well TD 38618" @ 977 Heeb. 3386 Tor. 3401Br. lime 3486 Lans. 3496 Cong. 3788Simp. 3806 Arb. 3855 TD 38595" @ 3857 CO to 3859 S/ 102 bo 4 hr.DD 3861 S/ 41 boph 2 hr.Comp. 3000 bopd